


Gidw.

PROJECT Phase II SHEET _____ OF _____

SUBJECT _____ DATE 5-8-18

JOB NO 4447

BY At/As

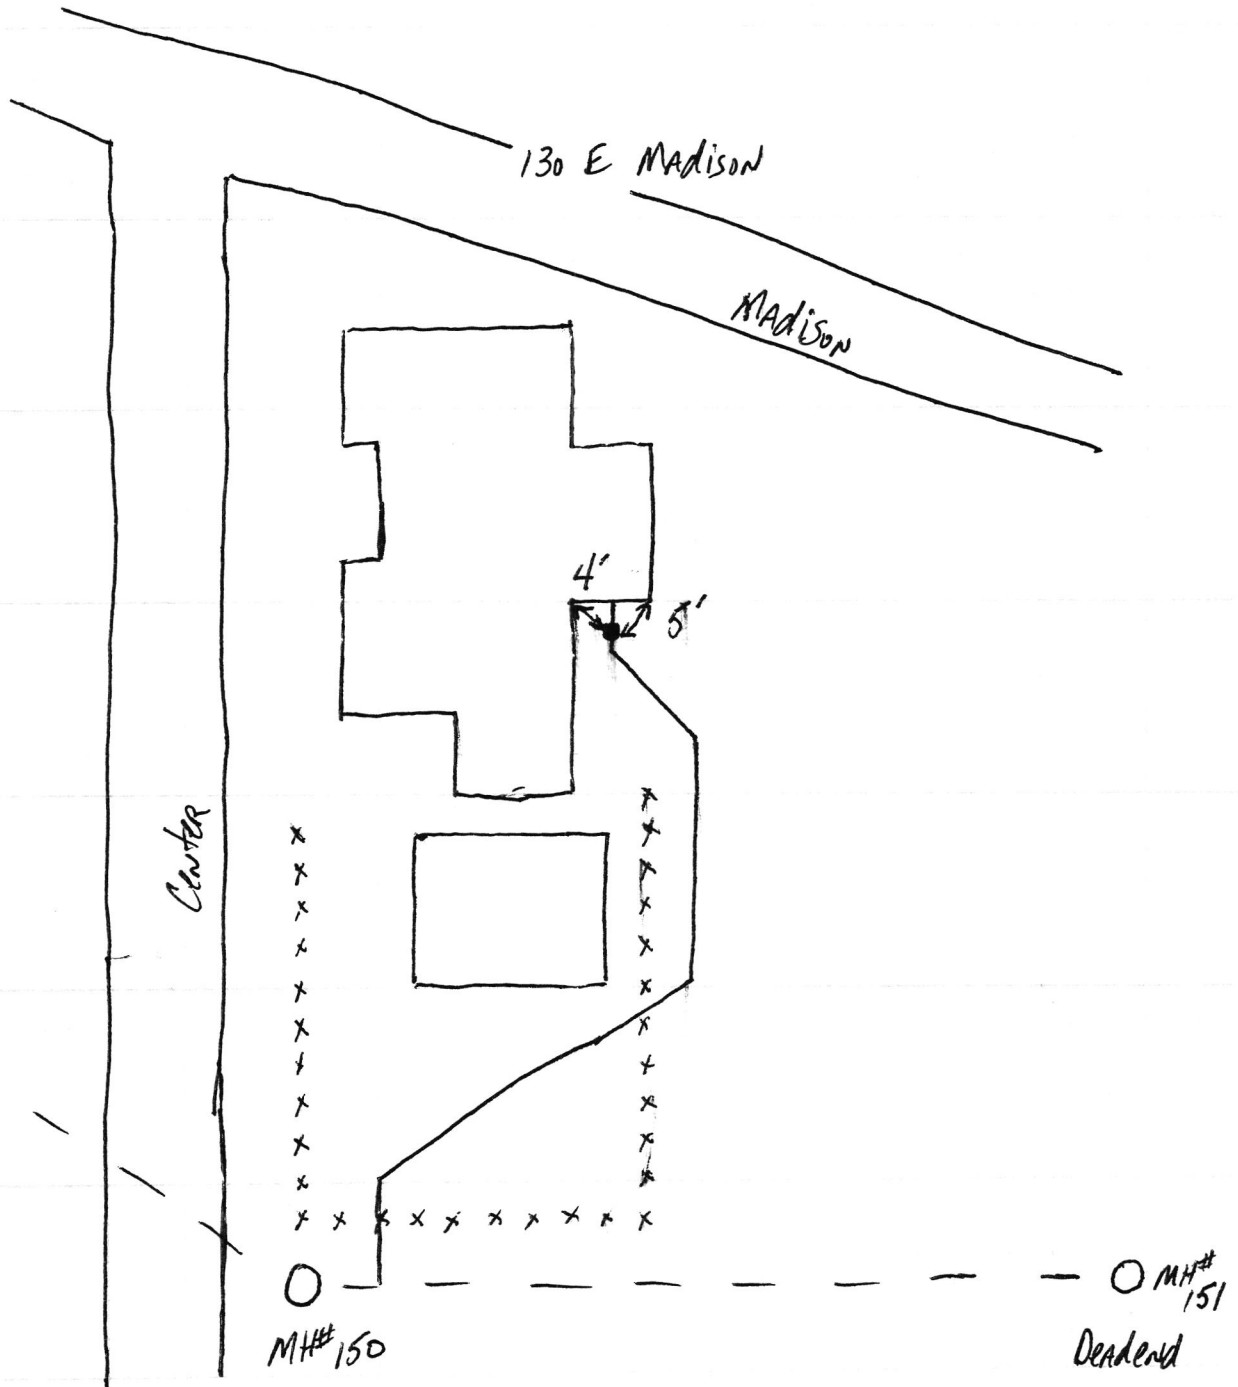

GIRL

PROJECT _____


Roche

SUBJECT _____

D. Peter Maniago
Corporate Account Director, CRO
Roche Diagnostics Corporation
9115 Hague Road, PO Box 50457
Indianapolis, IN 46250
Tel. 317-385-1547
peter.maniago@roche.com
www.roche.com
www.usdiagnostics.roche.com

Home

5411 N. ILLINOIS ST
Indianapolis, IN 46208

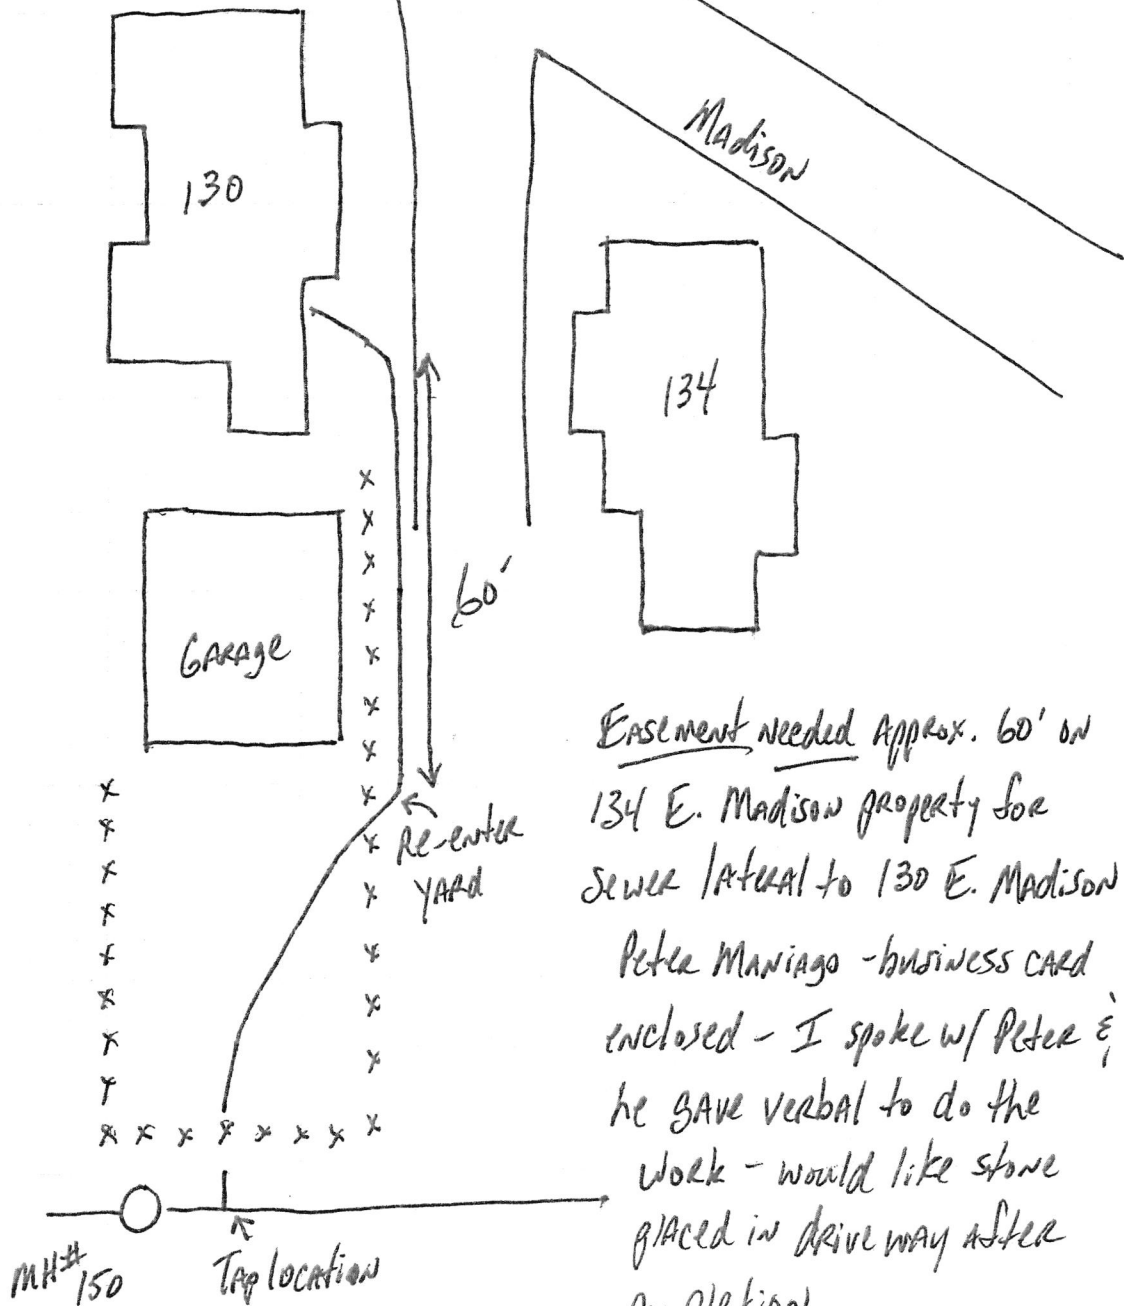

Easement needed Approx. 60' on
134 E. Madison property for
sewer lateral to 130 E. Madison

Peter Maniago - business card
enclosed - I spoke w/ Peter &
he gave verbal to do the
work - would like stone
placed in driveway after
completion

130 Madison

S&P Phase II

5.14.18

