


Gidw.

PROJECT Phase II SHEET _____ OF _____

SUBJECT _____ DATE 3-15-18

JOB NO. 4447

BY Atlas

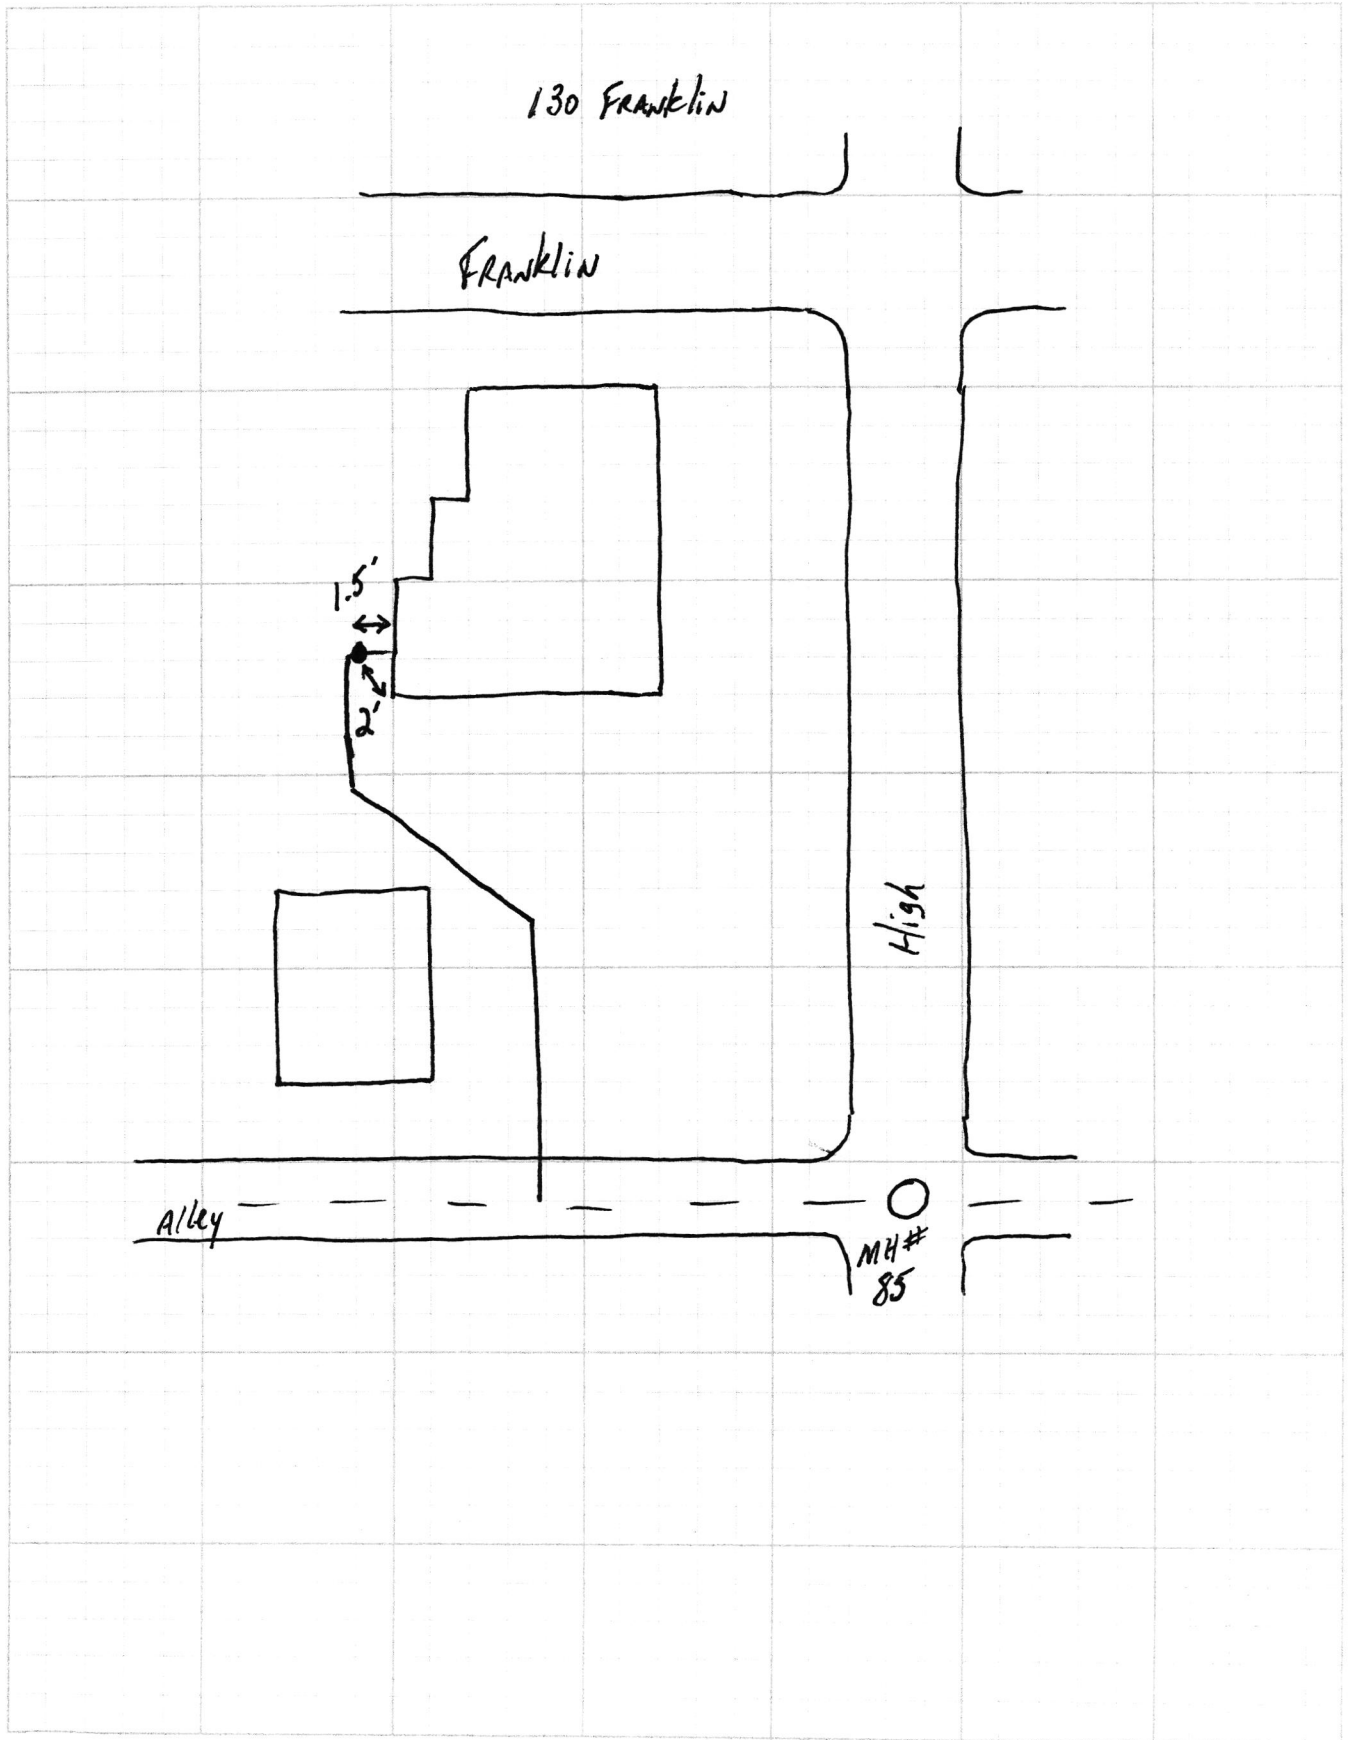

130 Franklin

SRP Phase II

