




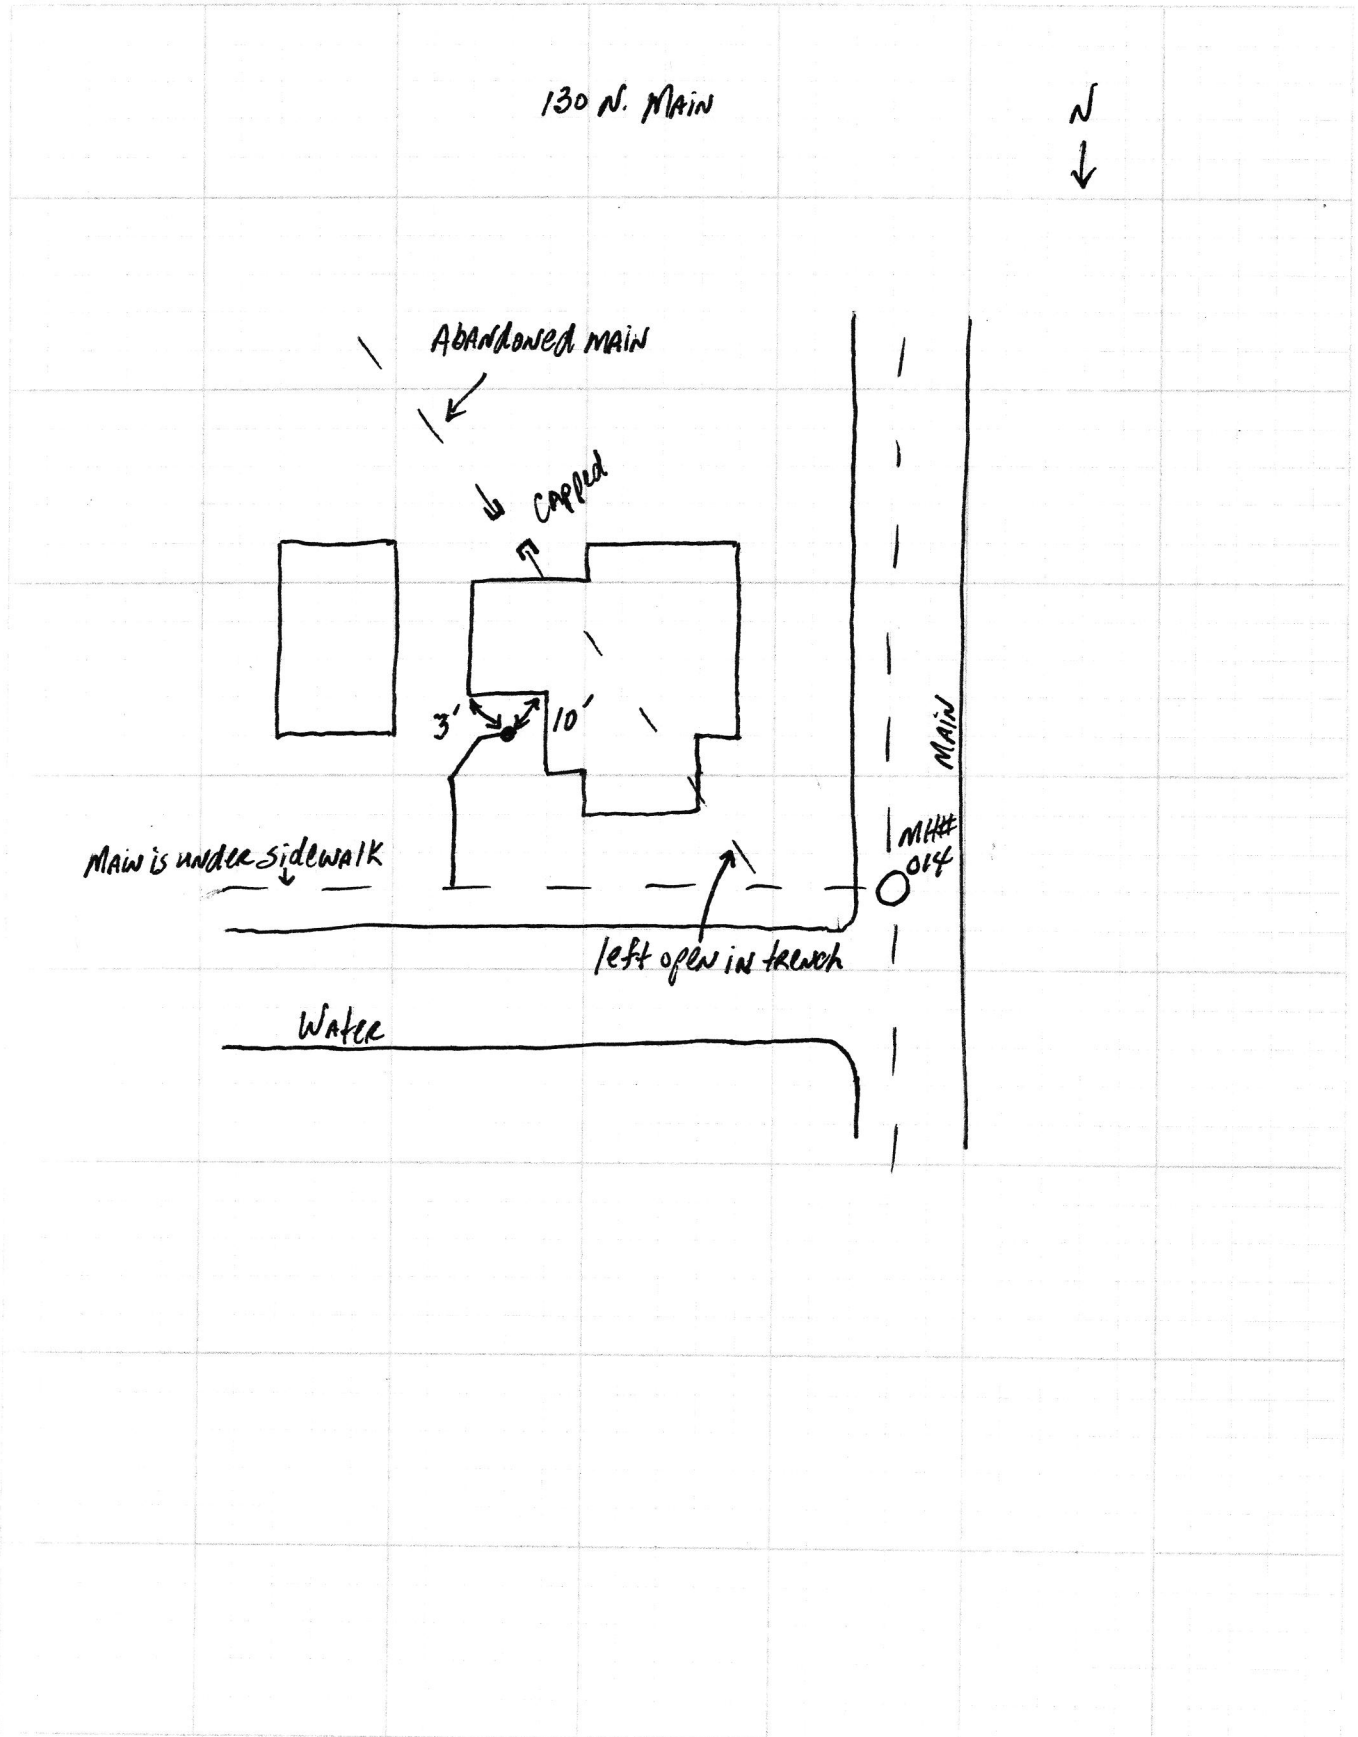

130-123 n Main

SAC Phase II

8.15.18





130 n main st

3.26.19

Tim McCurdy

