

add order
on file



FALL CREEK REGIONAL WASTE DISTRICT

9378 S. 650 West PO Box 59
Pendleton, IN 46064-0059 778-7544

13-30811.00

APPLICATION FOR SEWER PERMIT

Nº 2165

Date 12-8-94

Permit Void 90 days from Date of Issuance

Owner Name Barry Noble

Property Address 130 W Hawthorne Dr.

Lot # Lt. 13, Deerfield P.O. Box _____

Town Pendleton, IN Zip Code 46064

Phone _____ City Water _____ Well _____

\$ 500.00 Tap on Fee Paid

\$ 25.00 Inspection fee paid

Application is hereby made for connection to the Fall Creek Regional Waste District Sewer System for the above listed property - Permit Type: Residential ☒, Commercial _____, Industrial _____, or Governmental/Institutional _____. User Information _____.

All workmanship and materials shall conform to the standards of the District Ordinance as described in Ordinance 84-2 and 84-3 as amended. Acceptance and approval must be made by the District inspector or his duly authorized representative before backfilling and final connection is made to the main sewer lines. Any violation of applicable regulations will cause all lines and appurtenances in violation to be removed and replaced at the owners expense.

The Fall Creek Regional Waste District is responsible for the inspection, approval of materials, and installation techniques only. All costs for materials and installation and any liabilities resulting from same is the sole responsibility of the property owner.

I have read and fully understand the above provisions and agree to comply by said provisions.

Cinda D. Sheng
APPLICANT(S) SIGNATURE

INSPECTOR Ben.

Date inspected 1-3-95 Approved ☒ Rejected _____

Reason for rejection _____

Date reinspected _____ Approved _____ Rejected _____

Notes:

Size Pipe 6"

Type Pipe SDR35

Basement Yes ☐ No ☒

Sump Pump Yes ☐ No ☒

Downspout to Ground Yes ☒ No _____


Septic Tank Pumped & filled Yes ☐ No ☒

Contractor Deshong

Special Conditions _____

Existing Home ☐

New Construction ☒

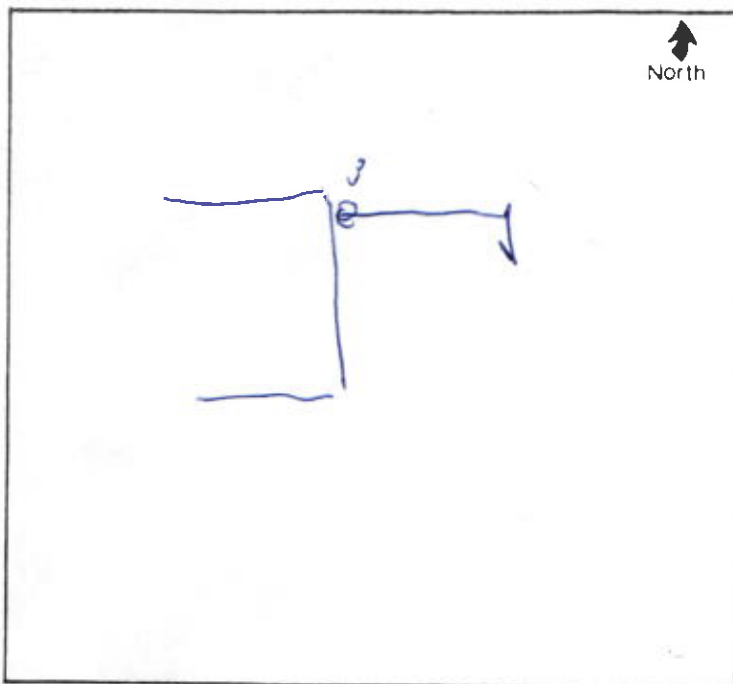



FALL CREEK REGIONAL WASTE DISTRICT

9378 S. 650 West PO Box 59
Pendleton, IN 46064-0059 778-7544

Nº 2161

APPLICATION FOR SEWER PERMIT

Date 11/3/94

Permit Void 90 days from Date of Issuance

Owner Name Heritage Homes

Property Address Hawthorn

Lot # _____ P.O. Box _____

Town Pendleton, IN Zip Code _____

Phone _____ City Water ☒ Well ☐

\$ _____ Tap on Fee Paid

\$ _____ Inspection fee paid

Application is hereby made for connection to the Fall Creek Regional Waste District Sewer System for the above listed property - Permit Type: Residential ☒, Commercial _____, Industrial _____, or Governmental/Institutional _____. User Information _____.

All workmanship and materials shall conform to the standards of the District Ordinance as described in Ordinance 84-2 and 84-3 as amended. Acceptance and approval must be made by the District inspector or his duly authorized representative before backfilling and final connection is made to the main sewer lines. Any violation of applicable regulations will cause all lines and appurtenances in violation to be removed and replaced at the owners expense.

The Fall Creek Regional Waste District is responsible for the inspection, approval of materials, and installation techniques only. All costs for materials and installation and any liabilities resulting from same is the sole responsibility of the property owner.

I have read and fully understand the above provisions and agree to comply by said provisions.

APPLICANT(S) SIGNATURE _____

INSPECTOR _____

Date inspected _____ Approved _____ Rejected _____

Reason for rejection _____

Date reinspected _____ Approved _____ Rejected _____

Notes:

Size Pipe _____"

Type Pipe _____

Basement Yes _____ No _____

Sump Pump Yes _____ No _____

Downspout to Ground Yes _____ No _____

Septic Tank Pumped & filled Yes _____ No _____

Contractor _____

Special Conditions _____

Existing Home _____

New Construction _____



PENDLETON WATER COMPANY

METER ORDER

No. 003527

Account Number	13-30811.	Book	Page	Date Issued	1-3-95	Date Wanted	1-3-95	Issued By	CM
Phone Number				Hour					

OUT

00 IN

Name				Name			
Location				Location			
Forwarding Address				Post Office Address			
Instructions		Meter No.	Meter Size	Meter Box No.	Reading	Date	By
Set							
Read Only	X	5465227	2 1/2		000	12-27-94	
Remove							
At Meter	Turn On						
	Turn Off						
Check For Leak	Yes	Computer Sheet	Meter Record		Reading Sheet	Customer Record	
	No						

REMARKS: (Didn't Bell Heritage Homes) first bill in Feb. Meter Dep. Rec. No. 4467 Amt. 300.00

Form No. 4-6-80

OVERRIDE AMOUNT
MONTH FINALED ON COMPUTER

OTHER INFORMATION: _____

CUSTOMER IN
ACCOUNT NUMBER : 13-30811.00 CODE: 1
CUSTOMER NAME : Barry Noble OWNER
SS#(S) : PHONE NO: _____
SERVICE ADDRESS : 130 W. Hawthorn Dr. lot 13- Deerfield
Pendleton, IN 46064-
MAILING ADDRESS : _____
(IF DIFFERENT THAN ABOVE)
IN DATE : ADMIN LETTER SENT: ~~YES~~
CALCULATIONS : 1/16/95 TO 2/16/95 OVERRIDE AMOUNT: _____
MONTH ADDED : March 95 MINIMUM AMOUNT: 14.35
OTHER INFO : permit # 2165 12/8/94