

Gidw.


PROJECT Phase II SHEET _____ OF _____

SUBJECT _____ DATE 5-1-18

JOB NO. 4447

BY Atlas

131 Franklin

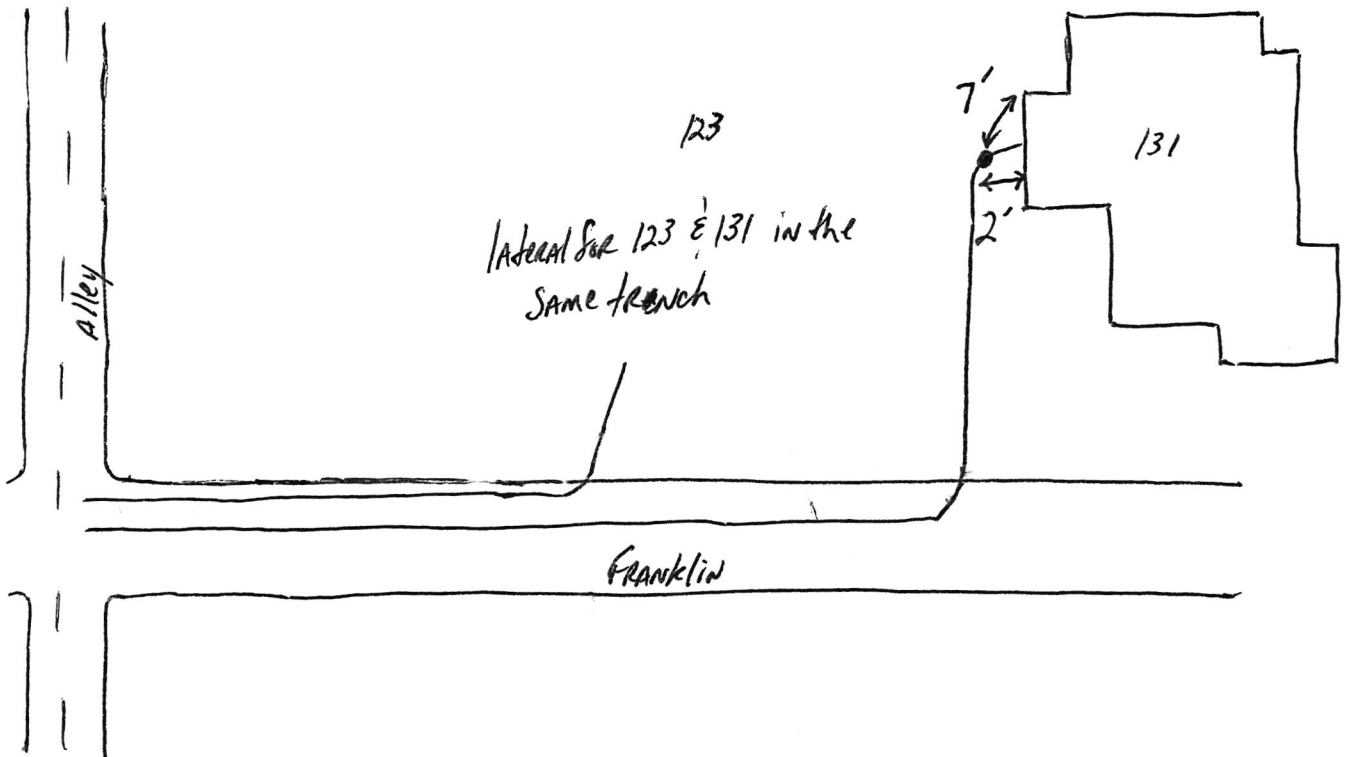

131 Franklin

SRP
Phase II

5-3-18

