

Gidw.

PROJECT

Phase II

SHEET

OF

SUBJECT

DATE

8-7-18

JOB NO.


4447

BY

Atlas

131 N. Pendleton

N
↓

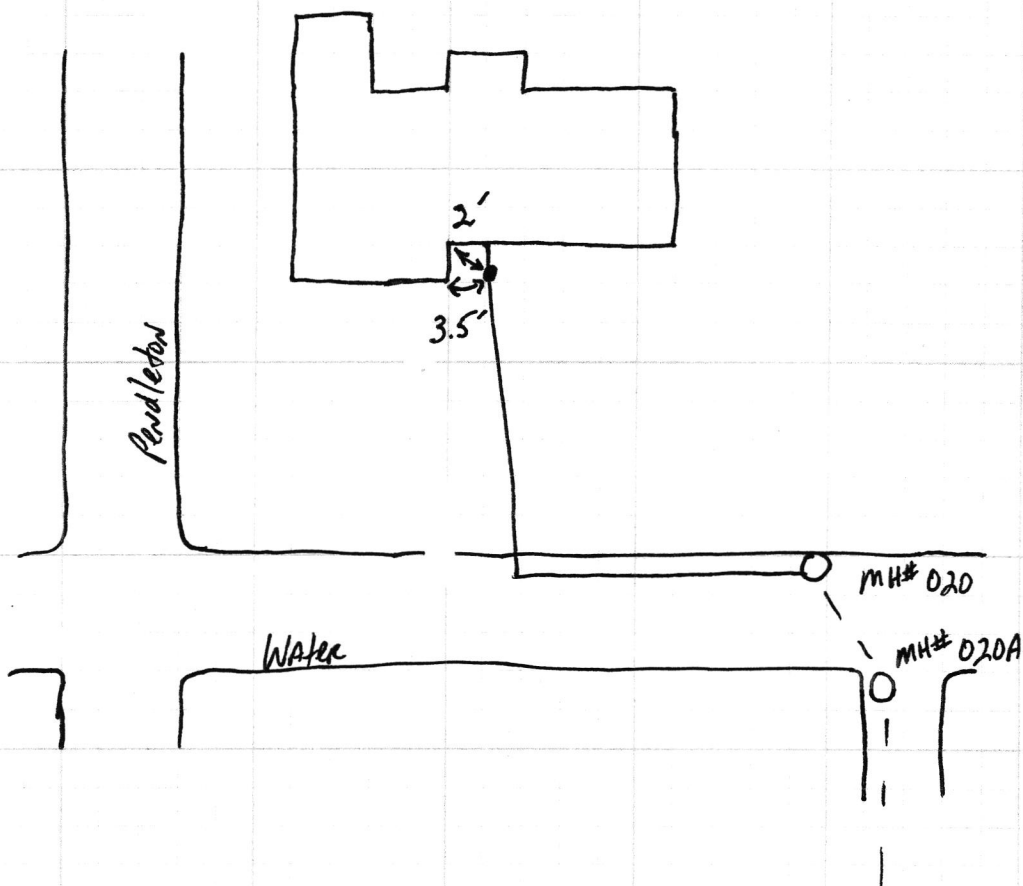

131 N Pendleton

SRF Phase II

8-15-18

