

G&W.


PROJECT Phase II SHEET _____ OF _____

SUBJECT _____ DATE 1-19-18

JOB NO. 4447

BY Atlas

133 E. Madison

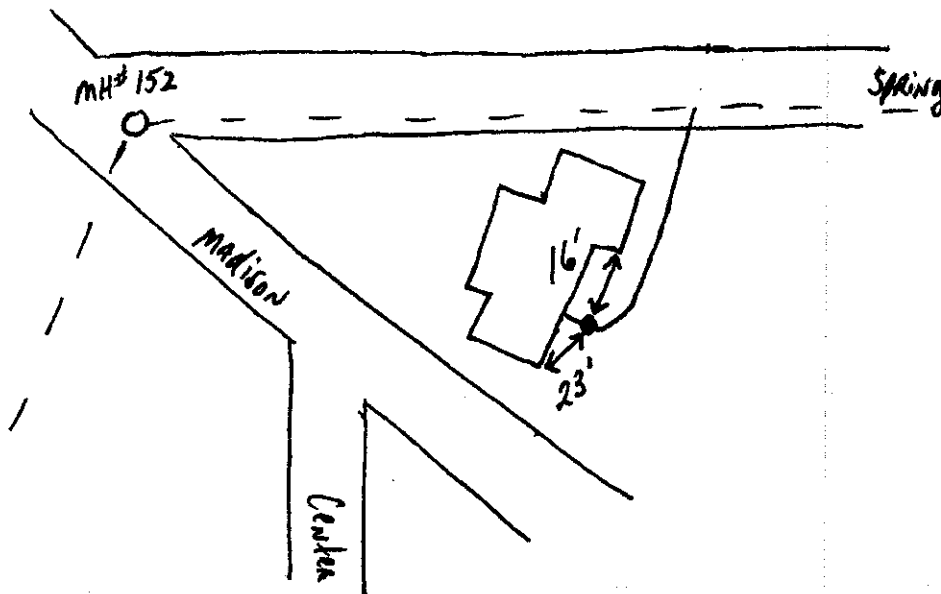

133 E madison

SRF Phase II

