



# FALL CREEK REGIONAL WASTE DISTRICT

Box 44, Pendleton, Indiana 46064

1-6002855.00

Nº 000297

## APPLICATION FOR SEWER PERMIT

Permit No. \_\_\_\_\_ Date 10-14-85  
Permit Void 90 days from Date of Issuance R1 Box 124  
Owner Name Carl Coleman Mc Cordsville In 46055  
Property Address 133 S. Houston  
Lot # \_\_\_\_\_ P.O. Box \_\_\_\_\_  
Town Ingalls, IN Zip Code 46048  
Phone \_\_\_\_\_ Water Meter \_\_\_\_\_"  
\$ 150.00 Tap on Fee Paid  
\$ 25.00 Inspection fee paid

Application is hereby made for connection to the Fall Creek Regional Waste District Sewer System for the above listed property - Permit Type: Residential ☒, Commercial \_\_\_\_\_, Industrial \_\_\_\_\_, or Governmental/Institutional \_\_\_\_\_. User Information \_\_\_\_\_.

All workmanship and materials shall conform to the standards of the District Ordinance as described in Ordinance 84-2 and 84-3 as amended. Acceptance and approval must be made by the District inspector or his duly authorized representative before backfilling and final connection is made to the main sewer lines. Any violation of applicable regulations will cause all lines and appurtenances in violation to be removed and replaced at the owners expense.

The Fall Creek Regional Waste District is responsible for the inspection, approval of materials, and installation techniques only. All costs for materials and installation and any liabilities resulting from same is the sole responsibility of the property owner.

I have read and fully understand the above provisions and agree to comply by said provisions.


☒ Carl D. Coleman  
APPLICANT(S) SIGNATURE

\*\*\*\*\*

INSPECTOR [Signature]  
Date inspected 11-6 Approved \_\_\_\_\_ Rejected \_\_\_\_\_  
Reason for rejection \_\_\_\_\_

Date reinspected \_\_\_\_\_ Approved \_\_\_\_\_ Rejected \_\_\_\_\_

Notes:  
Size Pipe 6"  
Type Pipe PVC  
Basement Yes ☒ No \_\_\_\_\_  
Sump Pump Yes ☒ No OUTDOOR  
Downspout to Ground Yes ☒ No \_\_\_\_\_  
Septic Tank Pumped & filled Yes \_\_\_\_\_ No ☒  
Contractor L. KELLER  
Special Conditions \_\_\_\_\_

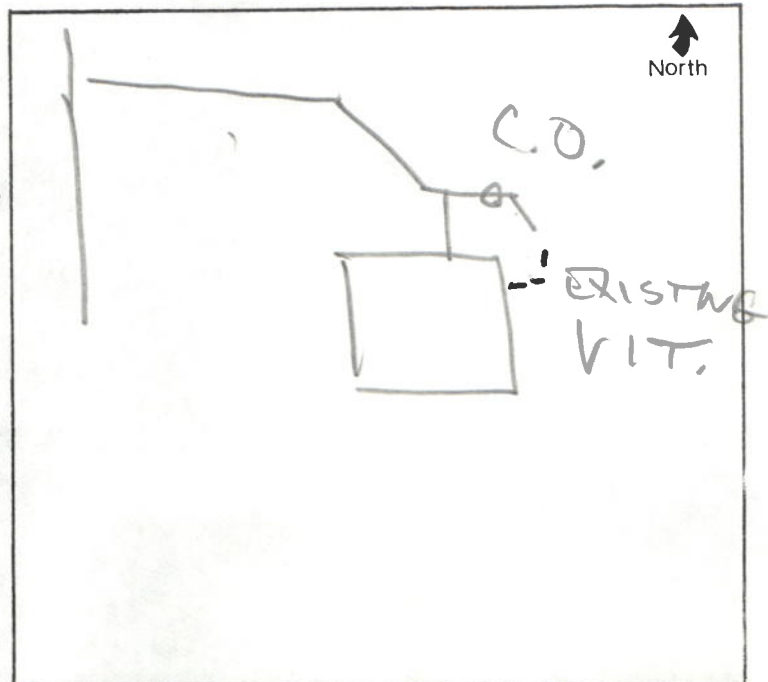



FALL CREEK REGIONAL WASTE DISTRICT

Box 44, Pendleton, Indiana 46064

torn down  
Mendon  
221

1-0002855.00

APPLICATION FOR SEWER PERMIT

Nº 000290

Permit No. \_\_\_\_\_ Date 10-14-85  
Permit Void 90 days from Date of Issuance  
Owner Name Carl D. Coleman  
Property Address 133 S. Houston  
Lot # \_\_\_\_\_ P.O. Box \_\_\_\_\_  
Town Ingalls, IN Zip Code 46048  
Phone 485-4530 Water Meter Ing  
\$ 150.00 Tap on Fee Paid  
\$ 25.00 Inspection fee paid

Application is hereby made for connection to the Fall Creek Regional Waste District Sewer System for the above listed property - Permit Type: Residential ☒, Commercial \_\_\_\_\_, Industrial \_\_\_\_\_, or Governmental/Institutional \_\_\_\_\_. User Information \_\_\_\_\_.

All workmanship and materials shall conform to the standards of the District Ordinance as described in Ordinance 84-2 and 84-3 as amended. Acceptance and approval must be made by the District inspector or his duly authorized representative before backfilling and final connection is made to the main sewer lines. Any violation of applicable regulations will cause all lines and appurtenances in violation to be removed and replaced at the owners expense.

The Fall Creek Regional Waste District is responsible for the inspection, approval of materials, and installation techniques only. All costs for materials and installation and any liabilities resulting from same is the sole responsibility of the property owner.

I have read and fully understand the above provisions and agree to comply by said provisions.

✓ Carl D. Coleman  
APPLICANT(S) SIGNATURE

\*\*\*\*\*

INSPECTOR DJH

Date inspected 1-6 Approved ✓ Rejected \_\_\_\_\_  
Reason for rejection \_\_\_\_\_

Date reinspected \_\_\_\_\_ Approved \_\_\_\_\_ Rejected \_\_\_\_\_

Notes:  
Size Pipe 6 "  
Type Pipe PVC  
Basement Yes \_\_\_\_\_ No ☒  
Sump Pump Yes \_\_\_\_\_ No ☒  
Downspout to Ground Yes ☒ No \_\_\_\_\_  
Septic Tank Pumped & filled Yes ☒ No \_\_\_\_\_  
Contractor L. Kozure  
Special Conditions \_\_\_\_\_

