


Gidw.

PROJECT Phase II SHEET _____ OF _____
SUBJECT _____ DATE 12-14-17
JOB NO. 4447
BY Atlas

134. E. Madison

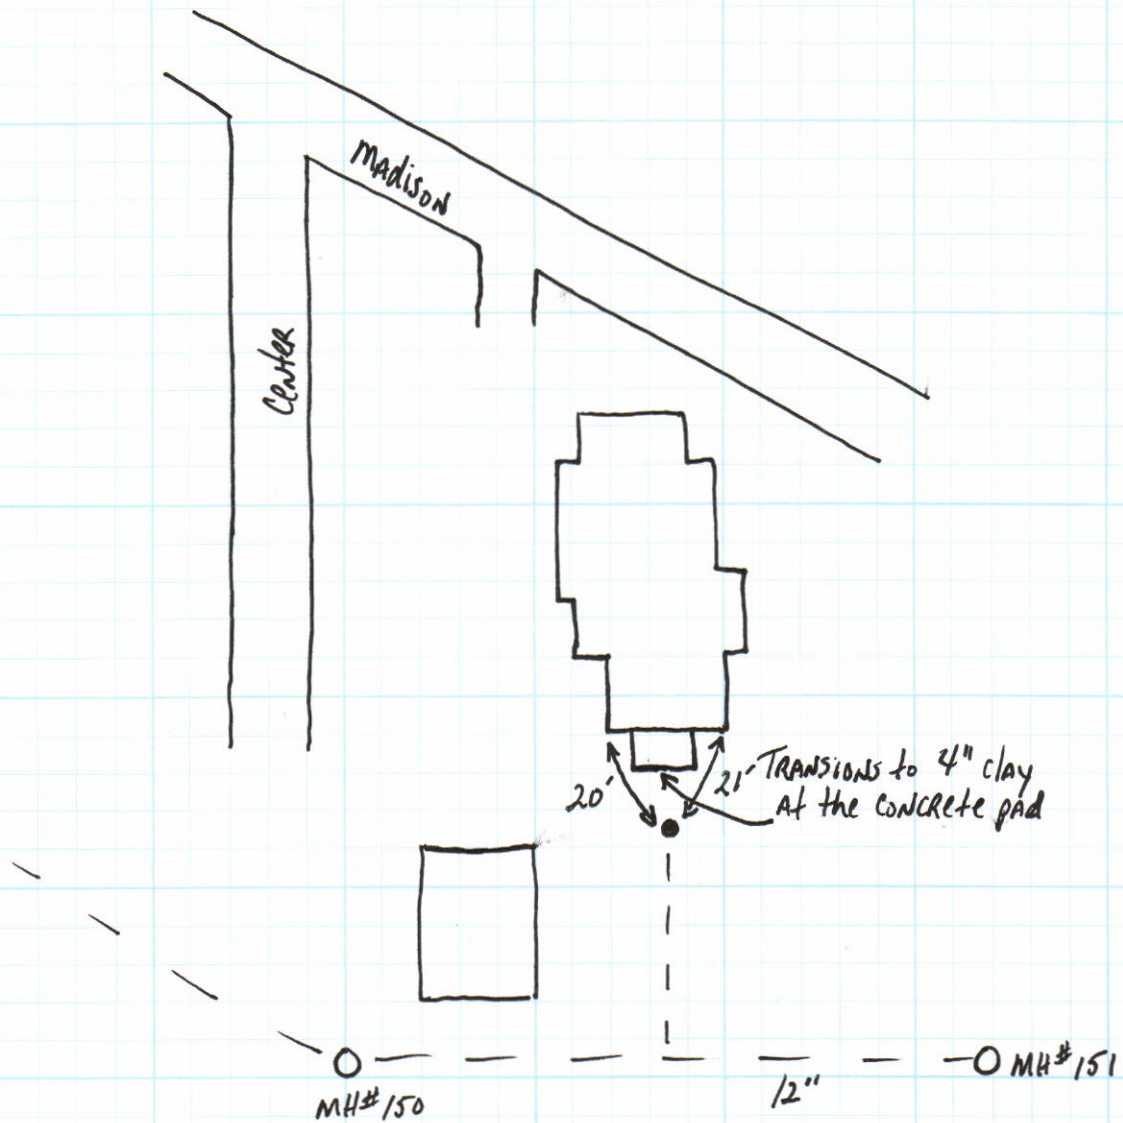

134 E Madison Ave

Lateral replacement

SRF Phase II
Dec '17

