


Lot 157 134 winding brook way Dr watson 7-19-22



Lot 142



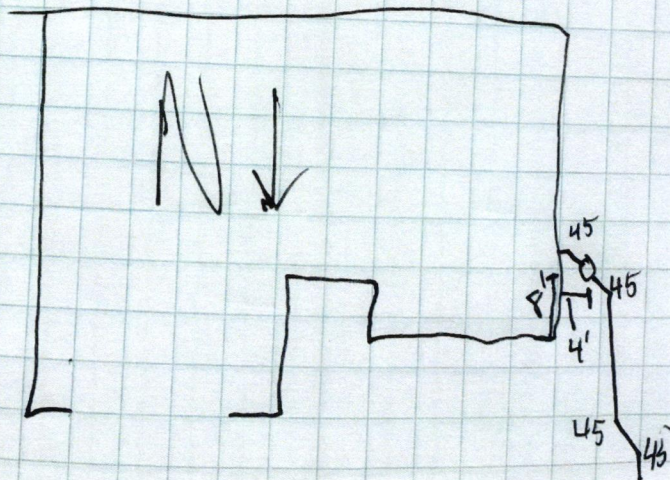



