


FALL CREEK REGIONAL WASTE DISTRICT



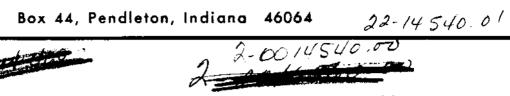

	2
APPLICATION FOR SE	WER PERMIT Nº 000822
Permit No Date	
Permit Void 90 days from Date of Issuan	•
Orman Nama Vanda 477017	(a
Property Address 15/2 (17)	Clarce 136 W 500 South
Lot # P.0	Por
Town 12 (12) 10 , IN	
Phone <u>645-1220</u> Water	
\$ 150,00 Tap on Fee Paid	
\$ 2500 Inspection fee paid	1
Application is hereby made for community waste District Sewer System for the above Residential, Commercial, Including User Information	ve listed property - Permit Type: dustrial, or Governmental/
All workmanship and materials shall conform to the standards of the District Ordinance as described in Ordinance 84-2 and 84-3 as amended. Acceptance and approval must be made by the District inspector or his duly authorized representative before backfilling and final connection is made to the main sewer lines. Any violation of applicable regulations will cause all lines and appurtenances in violation to be removed and replaced at the owners expense.	
The Fall Creek Regional Waste Distapproval of materials, and installation materials and installation and any liab sole responsibility of the property own. I have read and fully understand the comply by said provisions.	ilities resulting from same is the er.
X Bal Meline	
APPLICANT(S) SIG	GNATURE
, *****************************	********
INSPECTO	R Kin
Date inspected 4.7-81 Approved	Rejected
Reason for rejection	
Date reinspected A	oproved Rejected
Notes: C' "	
Size Pipe"	North
Type Pipe $\int U C$.	
Basement Yes No X	d 220
Sump Pump Yes No	Ţ
Downspout to Ground Yes No	
Septic Tank Pumped & filled Yes No	\$\frac{\P^{2^{\chi}}}{2^{\chi}}
Contractor ALM	
TAKE CHEE OF Whom They find	11 PCO
.\ .	
31/2003.00	
71469 15 69	Lac of the
	64).