

Gidw.


PROJECT Phase II SHEET _____ OF _____

SUBJECT _____ DATE 7-5-18

JOB NO. 4447

BY Atlas

136 W. Water

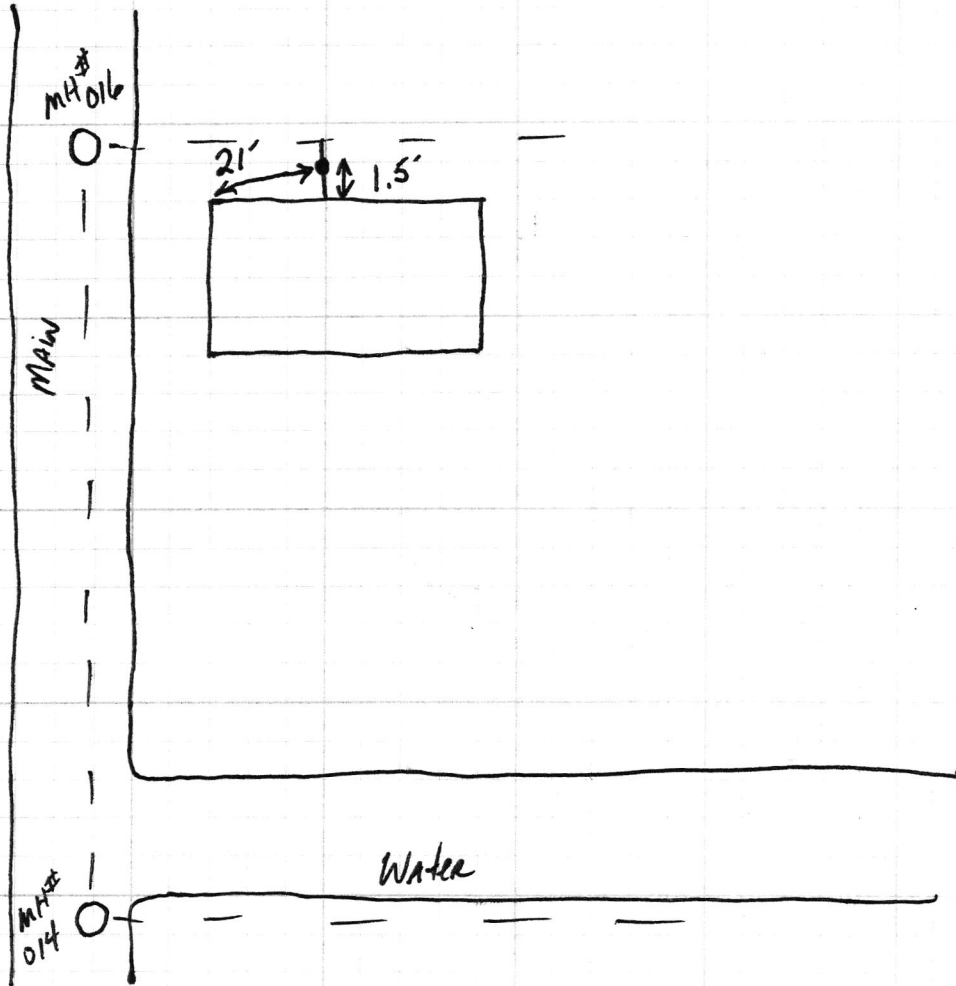



on these 11

7.11.18