


North

Drawing
+
1 picture
attached



Maplewood Huntz

Lot 185 143 Winding Brook Way
11/1/23 Dr. Watson

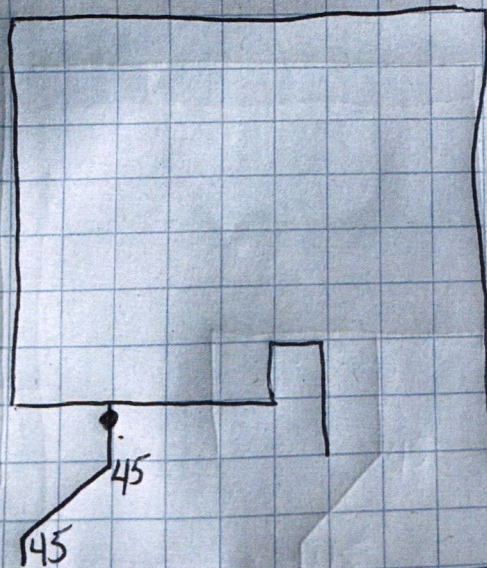

Cold Spring Huntz

Lot 73 288 Evening Bay St.
11/1/23

