

North

Drawing
+
2 pictures
attached




7965 East 106th Street, Fishers, IN 46038-2505
phone: 317.849.5935 fax: 317.849.5942

CONTROL# 94143 WEST

LOT AREA: 9,325 Sq. Ft.

M.F.F.=872.7

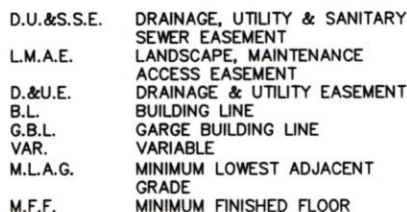

NOTE: THIS DRAWING IS NOT INTENDED TO BE REPRESENTED AS A RETRACEMENT OR ORIGINAL BOUNDARY SURVEY, A ROUTE SURVEY OR A SURVEYOR LOCATION REPORT.

50% MAXIMUM LOT COVERAGE

TOP OF CASTING=870.73

ALL UNDERGROUND SEWERS AND UTILITIES
SHOWN ARE PLOTTED BY SCALE FROM
DESIGN PLANS FURNISHED BY ENGINEER
THE ACTUAL FIELD LOCATION MAY VARY.

SOD:	2,107 ±	Sq. Ft.
SEEDING:	5,030 ±	Sq. Ft.
CONC. DRIVEWAY:	747 ±	Sq. Ft.
PRIVATE WALK:	54 ±	Sq. Ft.
PUBLIC WALK:	258 ±	Sq. Ft.

09/28/20 DTS




Carrick Glen Lot #15

Wills Exv.

1/7/21

N
↑

144 Carrick Glen Blvd.

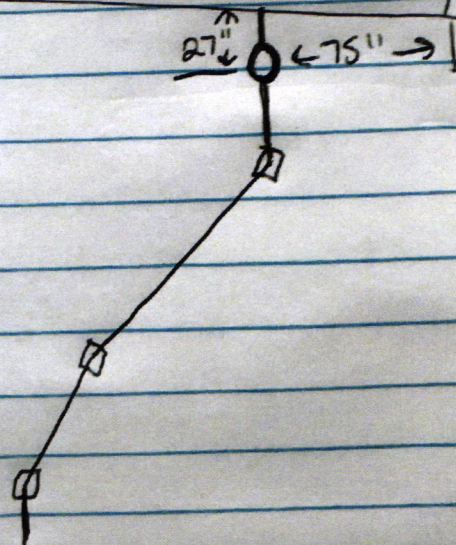





DR Horton
America's BuilderJP Morgan Chase Bank, N.A.
Syracuse, NY

Check Number 1170757

DRH Inc. Controlled Disb
1341 Horton Circle
Arlington, TX 76011

50-937

213

2720128

Date	Amount
09/23/20	\$*****760.00

Void after 6 months from date of issue

SEVEN HUNDRED SIXTY AND 00/100 *****

Pay To The Order Of:
FALL CREEK REGIONAL WASTE DISTRICT
9378 SOUTH 650 WEST
PENDLETON IN 46064D.L. Horton

Rec # 011395