



FALL CREEK REGIONAL WASTE DISTRICT

9378 S. 650 West PO Box 59
Pendleton, IN 46064-0059 778-7544

13-30097.00

add order
on file

Frank Dombroski

No 2351

APPLICATION FOR SEWER PERMIT

Date 3/29/96

Permit Void 90 days from Date of Issuance

Owner Name MUSTIN BUILDERS INC.

Property Address 145 Hawthorn

Lot # 5 Deerfield P.O. Box

Town Pendleton IN Zip Code 46064

Phone City Water Well

\$ 500.00 Tap on Fee Paid

\$ 25.00 Inspection fee paid

Application is hereby made for connection to the Fall Creek Regional Waste District Sewer System for the above listed property - Permit Type: Residential ☒, Commercial ☐, Industrial ☐, or Governmental/Institutional ☐. User Information

All workmanship and materials shall conform to the standards of the District Ordinance as described in Ordinance 84-2 and 84-3 as amended. Acceptance and approval must be made by the District inspector or his duly authorized representative before backfilling and final connection is made to the main sewer lines. Any violation of applicable regulations will cause all lines and appurtenances in violation to be removed and replaced at the owners expense.

The Fall Creek Regional Waste District is responsible for the inspection, approval of materials, and installation techniques only. All costs for materials and installation and any liabilities resulting from same is the sole responsibility of the property owner.

I have read and fully understand the above provisions and agree to comply by said provisions.

Mustin Builders Inc. by John E Mustin
APPLICANT(S) SIGNATURE

INSPECTOR

Date inspected 6/11/96 Approved ☒ Rejected ☐

Reason for rejection

Date reinspected Approved Rejected

Notes:

Size Pipe 4"

Type Pipe PVC

Basement Yes No ☒

Sump Pump Yes No ☒

Downspout to Ground Yes ☒ No


Septic Tank Pumped & filled Yes No ☒

Contractor Smith

Special Conditions

Existing Home

New Construction ☒

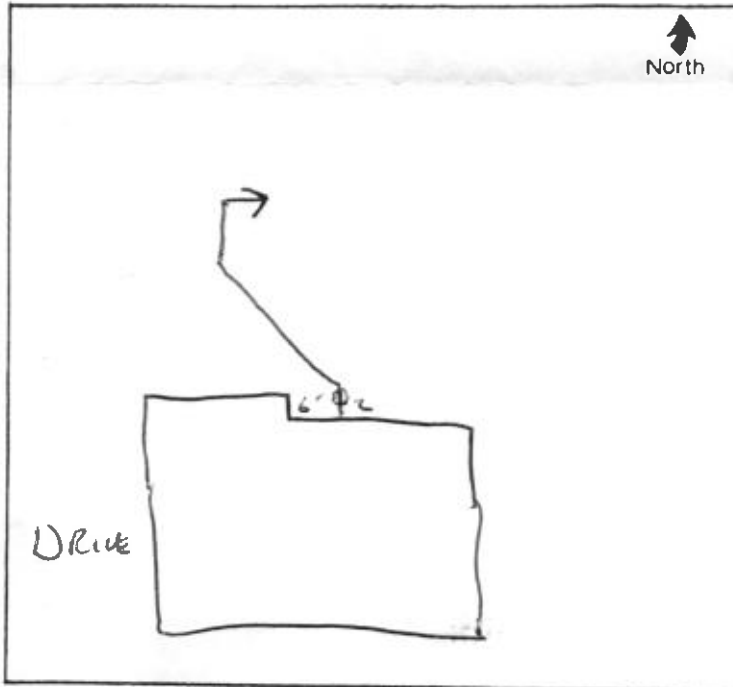

14-1 CREEK REGIONAL WASTE DISTRICT

NO 2351

MARTIN BARRICK INC.

200.00

2250

Walter B. Barrick, Jr. President

