

Fall Creek Regional Waste District  
9378 S 650 W, P.O. Box 59, Pendleton, IN 46064  
765-778-7544

#6666

Agreement for Sanitary Sewer Service

This Agreement made and entered into this 8 day of August, 2017, between Fall Creek Regional Waste District ("District") and Mustin Builders ("Applicant") regarding the provision of sanitary sewer service, and the assignment of capacity in and connection to, the District's facilities for the premises located at 145 Warwick Way Pendleton, IN 46064  
Pendle Pointe Lot #84

Now therefore, the parties, in consideration of the mutual promises set out in this Agreement, the receipt and sufficiency of which is hereby acknowledged, agree as follows:

1. The Applicant agrees that all workmanship and materials shall conform to all District ordinances and the District's construction standards. District must accept and approve all work and materials before backfilling and final connection is made to the sewer mains. Any violation of this provision will cause all lines and appurtenances in violation to be removed and replaced at the Applicant's expense.
2. The District shall have the right to enter upon the Applicant's premises at all reasonable times to inspect, repair, or replace any equipment used in connection with the District's service or which has an impact on said service.
3. The Applicant shall be responsible for all monthly user rates, capacity charges, and tap fees. The failure to pay any rate charge or fee may result in a lien against the property and/or the termination of service to the property, the cost of which will be borne by Applicant, including, but not limited to, all attorney's fees and collection costs.
4. The District shall not be responsible for any damages as a result of any failure to supply service unless said damages are due to default, neglect or culpability on the part of the District.
5. If there is an available sanitary sewer within three hundred (300) feet of the property line, the property owner shall be required to connect to the District's sanitary sewer system.
6. The Applicant and District agree that the provision of sanitary sewer service touches and concerns the property and the terms of this Agreement bind the District and Applicant and their heirs, executors, administrators, personal representatives, successors, agents, attorneys, assigns, designees, and transferees.

The parties hereto have read and fully understand the above provisions and agree to comply with said provisions.

FALL CREEK REGIONAL WASTE DISTRICT


Signature Rachel E. Anderson

APPLICANT

Signature [Signature]

STATE OF INDIANA )  
 ) SS:  
COUNTY OF MADISON )

SUBSCRIBED and sworn to before me this 8 day of August, 2017

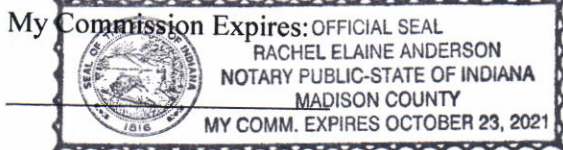

Signature Rachel E. Anderson

Printed Rachel E. Anderson

Notary Public

Resident of Madison County

\*\*\*\*\*

Inspector SN Date Inspected 8/15/17 Approved ☒ Rejected ☐  
Reason for Rejection \_\_\_\_\_

Date Reinspected \_\_\_\_\_ Approved \_\_\_\_\_ Rejected \_\_\_\_\_

Notes:

Size Pipe 6" Type Pipe 35

Basement Yes No

Sump Pump Yes No

Downspout to Ground Yes No


Septic Tank Pumped & Filled Yes No

Contractor Boton

Special Conditions \_\_\_\_\_

Existing Home \_\_\_\_\_

New Construction ☒

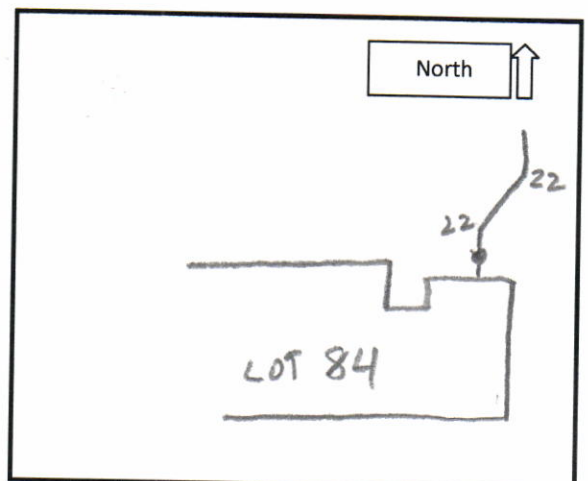

1 picture attached



Bondle Pointe  
Lot 84

145 warwick way

Steve Nicholson  
8.15.17







**MUSTIN BUILDERS, INC.**  
810 CENTRAL AVENUE  
ANDERSON, IN 46012  
PH. 765-644-8502

  
**STAR**  
Financial Bank  
PO Box 11409 • Fort Wayne, IN 46858-1409

**305248**

71-167/749

Ten Thousand One Hundred Ten & 00/100

DATE

8-8-17

CHECK NO.


30528

AMOUNT

\$10,110.<sup>00</sup>/<sub>100</sub>

PAY  
TO THE  
ORDER  
OF

FCRWD

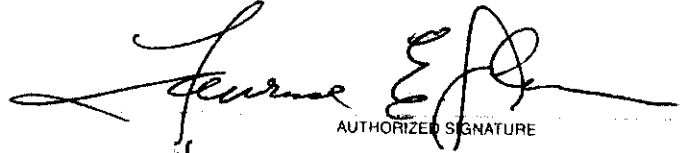  
AUTHORIZED SIGNATURE

MP

Rec. # 010657