



FALL CREEK REGIONAL WASTE DISTRICT

9378 S. 650 West PO Box 59
Pendleton, IN 46064-0059 778-7544

13. 30930.00

add order
on file

APPLICATION FOR SEWER PERMIT

Nº 2172

Date

2/3/95

Permit Void 90 days from Date of Issuance

Owner Name

Cowhony Michael Flynn

Property Address

147 Barbours Ct.

Lot # 23

P.O. Box

Town Pendleton

IN Zip Code

46064

Phone

City Water

Well

\$ 2700.00 Tap on Fee Paid

\$ 25.00 Inspection fee paid

Application is hereby made for connection to the Fall Creek Regional Waste District Sewer System for the above listed property - Permit Type: Residential ☒, Commercial ☐, Industrial ☐, or Governmental/Institutional ☐. User Information

All workmanship and materials shall conform to the standards of the District Ordinance as described in Ordinance 84-2 and 84-3 as amended. Acceptance and approval must be made by the District inspector or his duly authorized representative before backfilling and final connection is made to the main sewer lines. Any violation of applicable regulations will cause all lines and appurtenances in violation to be removed and replaced at the owners expense.

The Fall Creek Regional Waste District is responsible for the inspection, approval of materials, and installation techniques only. All costs for materials and installation and any liabilities resulting from same is the sole responsibility of the property owner.

I have read and fully understand the above provisions and agree to comply by said provisions.

APPLICANT(S) SIGNATURE

INSPECTOR

Date inspected

2-3-95

Approved

Rejected

Reason for rejection

Date reinspected

Approved

Rejected

Notes:

Size Pipe 6"

Type Pipe PVC

Basement Yes No ☒

Sump Pump Yes ? No

Downspout to Ground Yes ☒ No


Septic Tank Pumped & filled Yes No ☒

Contractor C.R. Conner

Special Conditions

Existing Home

New Construction

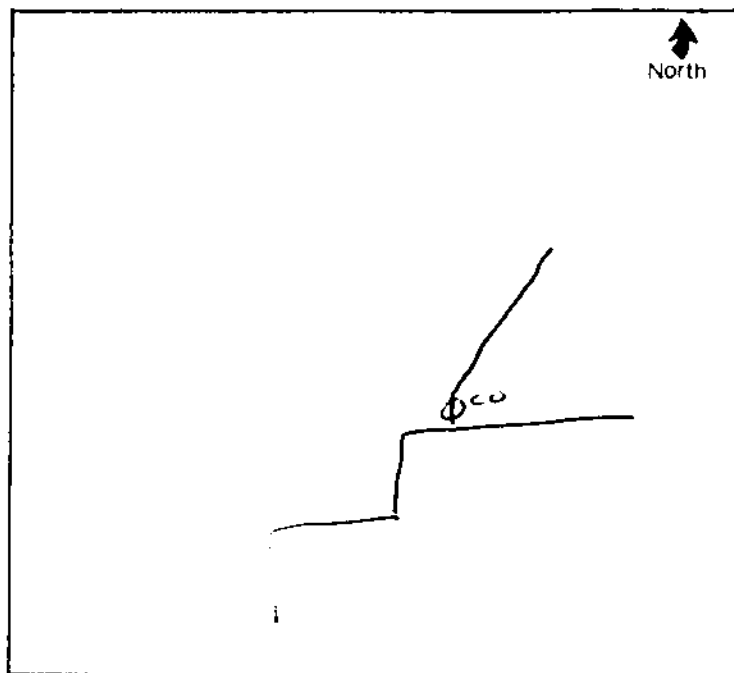

HERITAGE HOMES OF INDIANA INC.

2043

PH. 317-778-8139
117 N. PENDLETON AVE.
P. O. BOX 396
PENDLETON, IN 46064

20-5/740

06-03 1985

PAY
TO THE
ORDER OF Fall Creek Regional Waste \$ 2725⁰⁰

Two thousand seven hundred Twenty five ⁰⁰/₁₀₀ DOLLARS

National City Bank
Anderson, Indiana 46016

FOR _____

Mami DeShay MP

⑈002043⑈ ⑆074000065⑆