

#6465

148 Bay Ridge DR

Now therefore, the parties, in consideration of the mutual promises and covenants herein contained, and the receipt and sufficiency of which is hereby acknowledged, agree as follows:

1. The Applicant agrees that all workmanship and materials shall conform to all District ordinances and the District's construction standards. The District must accept and approve all work and materials before backfilling and final connection is made. The sewer main is the property of the District. Any violation of this provision will cause all lines and appurtenances in violation to be removed and replaced at the Applicant's expense.
2. The District shall have the right to enter upon the Applicant's premises at all reasonable times to inspect, repair, or replace any equipment used in connection with the District's service or which has an impact on said service.
3. The Applicant shall be responsible for all monthly user rates, capacity charges, and tap fees. The failure to pay any rate charge or fee may result in a lien against the property and/or the termination of service to the property, the cost of which will be borne by the applicant, including, but not limited to, all attorney's fees and collection costs.
4. The District shall not be responsible for any damages as a result of any failure to supply service unless said damages are due to default, neglect or culpability on the part of the District.
5. If there is an available sanitary sewer within three hundred (300) feet of the property line, the property owner shall be required to connect to the District's sanitary sewer system.
6. The Applicant and District agree that the provision of sanitary sewer service touches and concerns the property and the terms of this Agreement bind the District and Applicant and their heirs, executors, administrators, personal representatives, successors, agents, attorneys, assigns, designees, and transferees.

FALL CREEK REGIONAL WAST
Signature

[illegible]

SUBSCRIBED and sworn to be

My Commission Expires: Commission Expires November 20,
A Resident of
Hamilton County, Indiana
Rebecca Lynn Hunter, Notary Public


Notary Public
Resident of Hamilton County

Inspector SN Date Inspected 7/25/13 Approved ✓ Rejected _____
Reason for Rejection _____

Date Reinspected _____ Approved _____ Rejected _____

Notes:

Size Pipe 6" Type Pipe 35
Basement Yes No
Sump Pump Yes No
Downspout to Ground Yes No
Septic Tank Pumped & Filled Yes No
Contractor Balton
Special Conditions _____
Existing Home _____
New Construction ✓

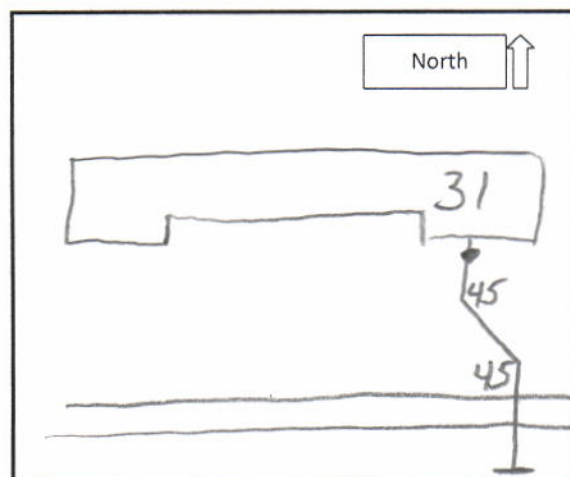

COPY

Original check is printed on chemical reactive paper with fluorescent fiber content and a watermark - hold up to a light to view



MUSTIN BUILDERS, INC.
810 CENTRAL AVENUE
ANDERSON, IN 46012
PH. 765-644-8502


STAR
Financial Bank
PO Box 11409 • Fort Wayne, IN 46858-1409

302321

71-167749

Six Thousand Seven Hundred Forty

DATE

7-19-13

CHECK NO


302321

AMOUNT

\$6,740.⁰⁰/₁₀₀

PAY
TO THE
ORDER
OF

Fall Creek Regional Waste

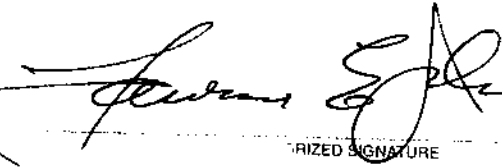
AUTHORIZED SIGNATURE

⑈ 302321 ⑈