


INDUSTRIAL GROUP

Huntzinger

Lot 55 1492 Bella Rita Ln.
7/18/23 R & R Plumbing

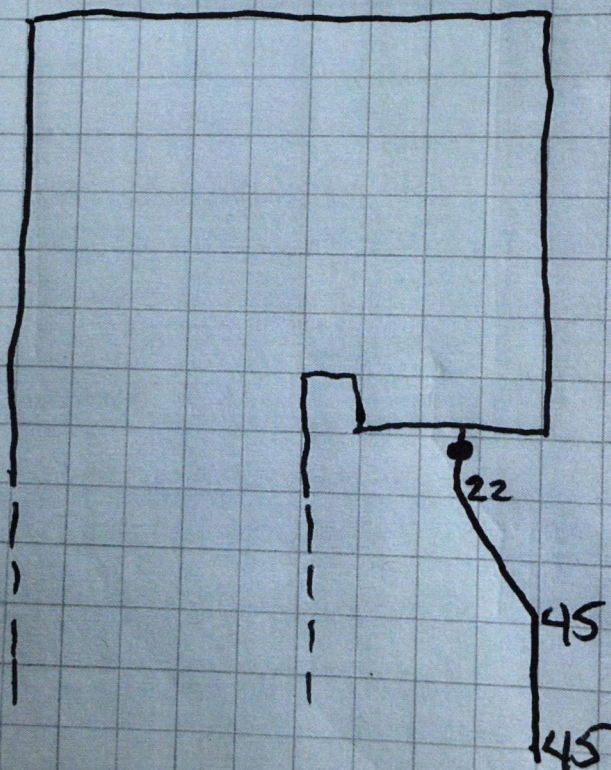

Indianapolis, IN
Fort Wayne, IN
Springfield, OH

Terre Haute, IN
Cincinnati, OH
Louisville, KY

hornerindustrial.com

