



FALL CREEK REGIONAL WASTE DISTRICT

9378 S. 650 West PO Box 59
Pendleton, IN 46064-0059 778-7544

add order
on file

22-28490.00

APPLICATION FOR SEWER PERMIT

No 2146

Date 10/7/94

Permit Void 90 days from Date of Issuance

Owner Name Rick Norris

Property Address 1515 W. HUNTSVILLE RD

Lot # _____ P.O. Box _____

Town Pendleton, IN Zip Code 46064

Phone _____ City Water _____ Well ☒

\$ 2700.00 Tap on Fee Paid

\$ 25.00 Inspection fee paid

Application is hereby made for connection to the Fall Creek Regional Waste District Sewer System for the above listed property - Permit Type: Residential ☒, Commercial _____, Industrial _____, or Governmental/Institutional _____. User Information _____.

All workmanship and materials shall conform to the standards of the District Ordinance as described in Ordinance 84-2 and 84-3 as amended. Acceptance and approval must be made by the District inspector or his duly authorized representative before backfilling and final connection is made to the main sewer lines. Any violation of applicable regulations will cause all lines and appurtenances in violation to be removed and replaced at the owners expense.

The Fall Creek Regional Waste District is responsible for the inspection, approval of materials, and installation techniques only. All costs for materials and installation and any liabilities resulting from same is the sole responsibility of the property owner.

I have read and fully understand the above provisions and agree to comply by said provisions.

APPLICANT(S) SIGNATURE _____

INSPECTOR BEN

Date inspected 10/7/94 Approved ☒ Rejected _____

Reason for rejection _____

Date reinspected _____ Approved _____ Rejected _____

Notes: 4" / 1 1/4 F.M

Size Pipe 4" / 1 1/4 F.M

Type Pipe PVC

Basement Yes _____ No _____

Sump Pump Yes _____ No _____

Downspout to Ground Yes ☒ No _____


Septic Tank Pumped & filled Yes _____ No ☒

Contractor BURKE

Special Conditions _____

Existing Home ☒

New Construction _____

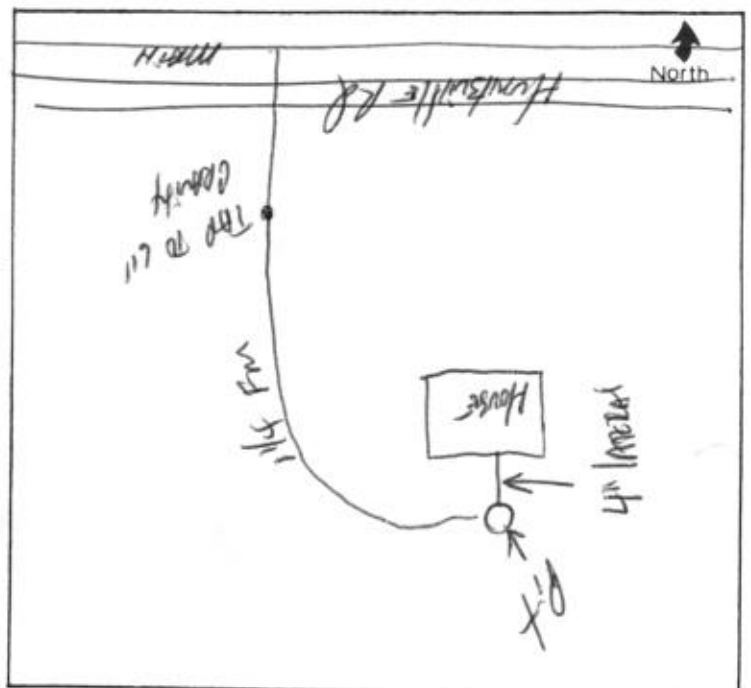

DATE: 10-17-94

TO: LISA

AT: KINGS TITLE

NUMBER OF PAGES: 1 Including this cover sheet.

FROM: JOE ROWLETT

FAXED from FALL CREEK REGIONAL WASTE DISTRICT (317) 778-7544
FAX (317) 778-7545

If you experience problems in receiving these pages
please call us at the above number.

LISA - 10/17/94

Thank you,

JOE

PLEASE USE THE FOLLOWING
DOLLAR AMOUNTS FOR FEES DUE
FALL CREEK REGIONAL WASTE
DISTRICT AT CLOSING OF REAL
ESTATE SALE - 1515 W.
HUNTSVILLE ROAD.

\$		AVAILABILITY
	2,000	FEE
	700	TAP FEE
	25	INSPECTION FEE
\$	<u>2,725</u>	TOTAL

THANKS - JOE ROWLETT