

# FALL CREEK REGIONAL WASTE DISTRICT

9378 S 650 WEST, P.O. BOX 59, PENDLETON, IN 46064

765-778-7544

## AGREEMENT FOR SANITARY SEWER SERVICE

This Agreement made and entered into this 19<sup>th</sup> day of October, 2005, between FALL CREEK REGIONAL WASTE DISTRICT ("District") and Davis Homes ("Applicant") regarding the provision of sanitary sewer service, and the assignment of capacity in, and connection to, the District's facilities for the premises located at 1522 Maplewood Lane Bendleton

**NOW THEREFORE**, the parties, in consideration of the mutual promises set out in this Agreement, the receipt and sufficiency of which is hereby acknowledged, agree as follows:

1. The Applicant agrees that all workmanship and materials shall conform to all District ordinances and the District's construction standards. District must accept and approve all work and materials before backfilling and final connection is made to the sewer mains. Any violation of this provision will cause all lines and appurtenances in violation to be removed and replaced at the Applicant's expense.
2. The District shall have the right to enter upon the Applicant's premises at all reasonable times to inspect, repair, or replace any equipment used in connection with the District's service or which has an impact on said service.
3. The Applicant shall be responsible for all monthly user rates, capacity charges, and tap fees. The failure to pay any rate charge or fee may result in a lien against the property and/or the termination of service to the property, the cost of which will be borne by Applicant, including, but not limited to, all attorney's fees and collection costs.
4. The District shall not be responsible for any damages as a result of any failure to supply service unless said damages are due to default, neglect or culpability on the part of the District.
5. If there is an available sanitary sewer within three hundred (300) feet of the property line, the property owner shall be required to connect to the District's sanitary sewer system.
6. The Applicant and District agree that the provision of sanitary sewer service touches and concerns the property and the terms of this Agreement bind the District and Applicant and their heirs, executors, administrators, personal representatives, successors, agents, attorneys, assigns, designees, and transferees.

The parties hereto have read and fully understand the above provisions and agree to comply with said provisions.

FALL CREEK REGIONAL WASTE DISTRICT  
Teresa Sutton  
Signature

APPLICANT Nancy A. Long  
Signature

[illegible]

SUBSCRIBED and sworn to before me this 19th day of October, 2005.

My Commission Expires:  
4-19-2008

Signature Teresa K. Hutton  
Printed Teresa K Hutton

**Notary Public**  
**Resident of Madison County**

\*\*\*\*\*  
INSPECTOR SN      DATE INSPECTED 12-12-05      APPROVED ✓      REJECTED

REASON FOR REJECTION

DATE REINSPECTED	APPROVED	REJECTED
------------------	----------	----------

NOTES: SIZE PIPE 6" TYPE PIPE 35

BASEMENT YES NO

SUMP PUMP YES NO

DOWNSPOUT TO GROUND YES NO


SEPTIC TANK PUMPED &amp; FILLED YES NO

CONTRACTOR *Harland*

### SPECIAL CONDITIONS

## EXISTING HOME

NEW CONSTRUCTION ✓

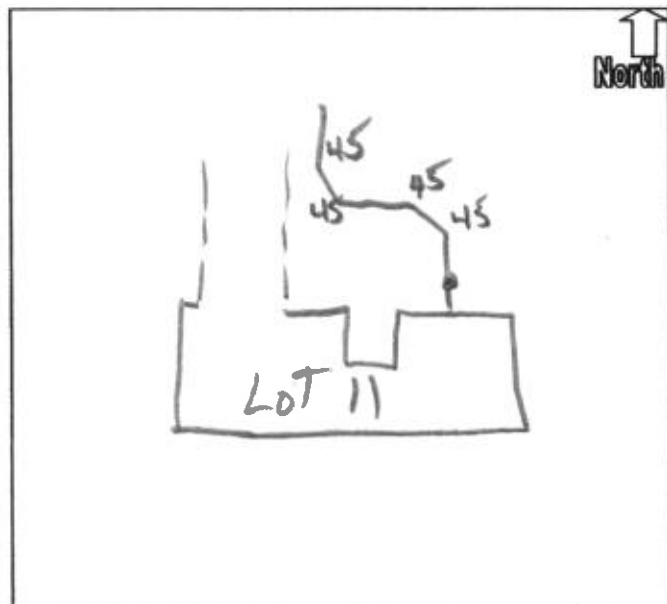

PAY TO:  
Fall Creek Reg Waste Dis  
9378 South 650 West  
Pendleton, IN 46064

Davis Homes, LLC

Page 1 of 1

VENDOR NO.	CHECK DATE	CHECK NO	CHECK TOTAL
fal93	10/18/2005	260856	\$2,635.00

Invoice	Date	Description	Gross Amt	Adjusts	Net Amount
hfm11	10/18/05	Sewer Permit	2635.00	0.00	2635.00
hfm11	1522	Maplewood Lane	hfm01	Huntzinger Farms-Maplewood	
Check Subtotal ----->>			2635.00	0.00	2635.00
=====					

Davis Homes, LLC  
3755 East 82nd Street  
Suite 120  
Indianapolis, IN 46240

First Indiana Bank  
Indianapolis, IN 46204

20-7043  
2749

CHECK NO.  
**260856**  
10/18/2005

PAY \*\*\*Two Thousand Six Hundred And Thirty Five Dollars Only\*\*\*\*\*

\*\*\*\$2,635.00\*

To  
The  
Order  
Of

Fall Creek Reg Waste Dis  
9378 South 650 West  
Pendleton, IN 46064

*Jerry Case*