

Fall Creek Regional Waste District
9378 S 650 W, P.O. Box 59, Pendleton, IN 46064
765-778-7544

#6466

Agreement for Sanitary Sewer Service

This Agreement made and entered into this 19 day of July, 2013, between Fall Creek Regional Waste District ("District") and Mushin ("Applicant") regarding the provision of sanitary sewer service, and the assignment of capacity in and connection to, the District's facilities for the premises located at Lot 32 Rende Point

Now therefore, the parties, in consideration of the mutual promises set out in this Agreement, the receipt and sufficiency of which is hereby acknowledged, agree as follows:

1. The Applicant agrees that all workmanship and materials shall conform to all District ordinances and the District's construction standards. District must accept and approve all work and materials before backfilling and final connection is made to the sewer mains. Any violation of this provision will cause all lines and appurtenances in violation to be removed and replaced at the Applicant's expense.
2. The District shall have the right to enter upon the Applicant's premises at all reasonable times to inspect, repair, or replace any equipment used in connection with the District's service or which has an impact on said service.
3. The Applicant shall be responsible for all monthly user rates, capacity charges, and tap fees. The failure to pay any rate charge or fee may result in a lien against the property and/or the termination of service to the property, the cost of which will be borne by Applicant, including, but not limited to, all attorney's fees and collection costs.
4. The District shall not be responsible for any damages as a result of any failure to supply service unless said damages are due to default, neglect or culpability on the part of the District.
5. If there is an available sanitary sewer within three hundred (300) feet of the property line, the property owner shall be required to connect to the District's sanitary sewer main.
6. The Applicant and District agree that the provision of sanitary sewer service, and the terms of this Agreement bind the District and Applicant and their heirs, executors, administrators, personal representatives, successors, agents, attorneys, assigns, designees, and transferees.

The parties hereto have read and fully understand the above provisions and agree to comply with said provisions.

FALL CREEK REGIONAL WASTE DISTRICT
Steve
Signature

APPLICANT
[Signature]
Signature

STATE OF INDIANA

COUNTY OF MADISON

SUBSCRIBED


My Commission Expires
Commission Expires
Hamilton County
Rebecca Lynn Hunter, Notary Public

July, 2013
Rebecca Lynn Hunter
Printed Rebecca Lynn Hunter
Notary Public
Resident of Hamilton County

Inspector SN Date Inspected 7/25/13 Approved ✓ Rejected _____
Reason for Rejection _____
Date Reinspected _____ Approved _____ Rejected _____

Notes:

Size Pipe 6" Type Pipe 35
Basement Yes No
Sump Pump Yes No
Downspout to Ground Yes No _____
Septic Tank Pumped & Filled Yes No _____
Contractor Bolton
Special Conditions _____
Existing Home _____
New Construction ✓

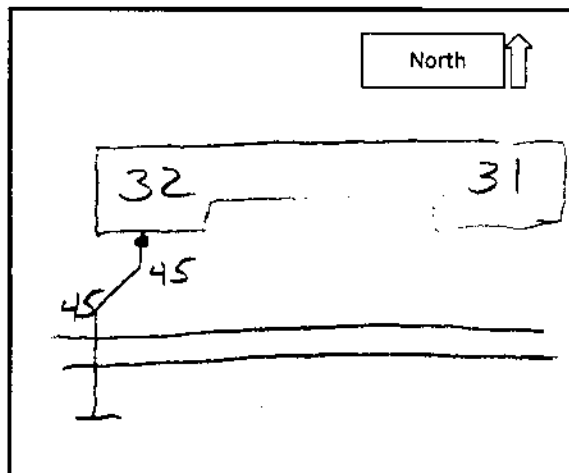

COPY

Original check is printed on chemical reactive paper with fluorescent fiber content and a watermark - hold up to a light to view



MUSTIN BUILDERS, INC.
810 CENTRAL AVENUE
ANDERSON, IN 46012
PH. 765-644-8502


STAR
Financial Bank
PO Box 11409 - Fort Wayne, IN 46858-1409

302321

71-167749

Six Thousand Seven Hundred Forty &

DATE

7-19-13

CHECK NO.


302321

AMOUNT

\$6,740.⁰⁰/₁₀₀

PAY
TO THE
ORDER
OF

Fall Creek Regional Waste

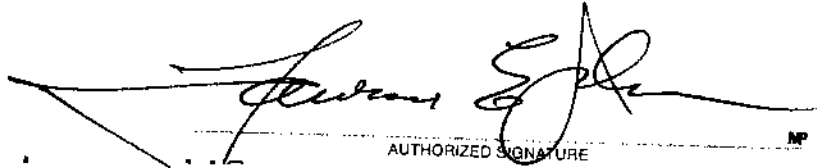
AUTHORIZED SIGNATURE

⑈ 302321 ⑈