#6552

Fall Creek Regional Waste District

9378 S 650 W, P.O. Box 59, Pendleton, IN 46064 765-778-7544

Agreement for Sanitary Sewer Service

This Agreement made and entered into this 7 day of January, 2014, between Fall Creek Regional Waste District ("District") and Arbor Hones, LLC ("Applicant") regarding the provision of sanitary sewer service, and the assignment of capacity in and connection to, the District's facilities for the premises located at 1564 Waplewood lane Plus John Library


Now therefore, the parties, in consideration of the mutual promises set out in this Agreement, the receipt and sufficiency of which is hereby acknowledged, agree as follows:

- The Applicant agrees that all workmanship and materials shall conform to all District ordinances
 and the District's construction standards. District must accept and approve all work and materials
 before backfilling and final connection is made to the sewer mains. Any violation of this
 provision will cause all lines and appurtenances in violation to be removed and replaced at the
 Applicant's expense.
- The District shall have the right to enter upon the Applicant's premises at all reasonable times to inspect, repair, or replace any equipment used in connection with the District's service or which has an impact on said service.
- 3. The Applicant shall be responsible for all monthly user rates, capacity charges, and tap fees. The failure to pay any rate charge or fee may result in a lien against the property and/or the termination of service to the property, the cost of which will be borne by Applicant, including, but not limited to, all attorney's fees and collection costs.
- 4. The District shall not be responsible for any damages as a result of any failure to supply service unless said damages are due to default, neglect or culpability on the part of the District.
- 5. If there is an available sanitary sewer within three hundred (300) feet of the property line, the property owner shall be required to connect to the District's sanitary sewer system.
- The Applicant and District agree that the provision of sanitary sewer service touches and
 concerns the property and the terms of this Agreement bind the District and Applicant and their
 heirs, executors, administrators, personal representatives, successors, agents, attorneys, assigns,
 designees, and transferees.

The parties hereto have read and fully understand the above provisions and agree to comply with said provisions.

provisions.	1 7
FALL CREEK REGIONAL WASTE DISTRICT Signature	APPLICANT agul Signaturo
STATE OF INDIANA)) SS: COUNTY OF MADISON)	
1	Lachel E. Anderson Notary Public Resident of Madison County
Inspector Date Inspected 271 Approved Rejected Rejected	
Notes: Size Pipe Basement Yes Sump Pump Yes No Downspout to Ground Yes Septic Tank Pumped & Filled Yes Contractor Special Conditions Existing Home New Construction Date Reinspected Approved Approved Approved Approved Approved Approved No Sump Pump Yes No	Rejected
	THISTIE WOOT) CTY

1 Picture attached

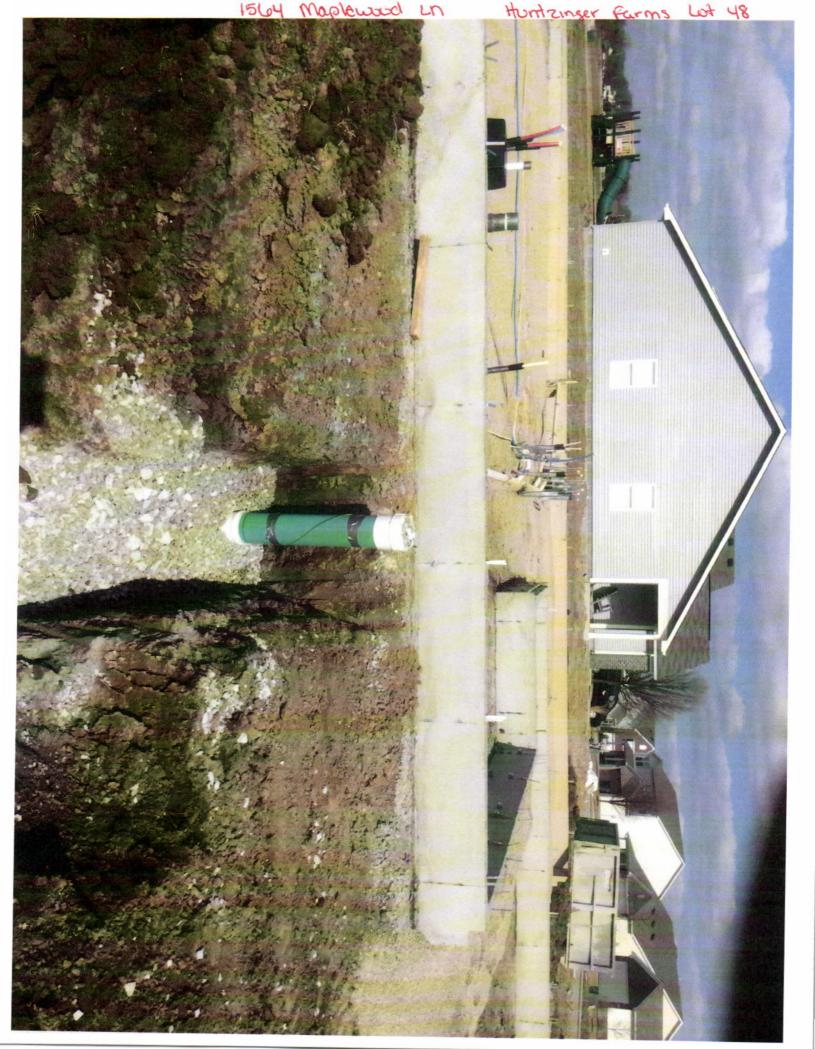

THIS CHECK HAS A COLORED BACKGROUND AND CONTAINS MULTIPLE SECURITY FEATURES - SEE BACK FOR DETAILS

ARBOR HOMES, L.L.C. PERMIT ACCOUNT 6626 E. 75TH STREET, SUITE 400 INDIANAPOLIS, IN 46250



027896

DATE 12/16/2015

PAY TO THE ORDER OF

Fall Creek Regional Waste District

3,370.00

Three Thousand Three Hundred And Seventy Dollars And 0/100

DOLLARS

NOT VALID FOR AMOUNTS OVER \$10,000

FOR

HUNTZ 48

SENSITE BY:

AUTHORIZED SIGNATURE

Cap + Tap fee Rec # 010420

1