



FALL CREEK REGIONAL WASTE DISTRICT

9378 S. 650 West PO Box 59
Pendleton, IN 46064-0059 778-7544

add order
on file
13-50425-00

APPLICATION FOR SEWER PERMIT

Nº 2147

Date 10-13-94

Permit Void 90 days from Date of Issuance

Owner Name Crossman Communities Royce Hagar

Property Address 159 Oxford Ave.

Lot # 48 P.O. Box _____

Town Pendleton, IN Zip Code 46064

Phone _____ City Water ☒ Well _____

\$ 700.⁰⁰ Tap on Fee Paid

\$ 25.⁰⁰ Inspection fee paid

Application is hereby made for connection to the Fall Creek Regional Waste District Sewer System for the above listed property - Permit Type: Residential ☒, Commercial _____, Industrial _____, or Governmental/Institutional _____. User Information _____.

All workmanship and materials shall conform to the standards of the District Ordinance as described in Ordinance 84-2 and 84-3 as amended. Acceptance and approval must be made by the District inspector or his duly authorized representative before backfilling and final connection is made to the main sewer lines. Any violation of applicable regulations will cause all lines and appurtenances in violation to be removed and replaced at the owners expense.

The Fall Creek Regional Waste District is responsible for the inspection, approval of materials, and installation techniques only. All costs for materials and installation and any liabilities resulting from same is the sole responsibility of the property owner.

I have read and fully understand the above provisions and agree to comply by said provisions.

[Signature]
APPLICANT(S) SIGNATURE

INSPECTOR B

Date inspected 5-3-95 Approved ☒ Rejected _____

Reason for rejection _____

Date reinspected _____ Approved _____ Rejected _____

Notes:

Size Pipe 6 "

Type Pipe PVC

Basement Yes _____ No ☒

Sump Pump Yes _____ No ☒

Downspout to Ground Yes ☒ No _____


Septic Tank Pumped & filled Yes _____ No ☒

Contractor DR Watson

Special Conditions _____

Existing Home _____

New Construction ☒

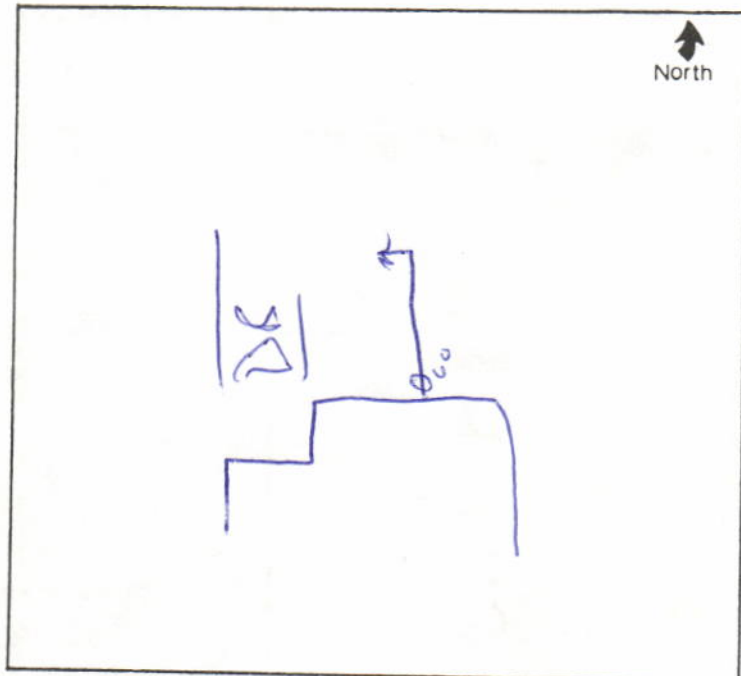



CONSULTING ENGINEERS LAND SURVEYORS


9900 Allison Rd. • P.O. Box 309007 • Indianapolis, IN 46258
(317) 849-5935 • 1-800-728-6817 • FAX (317) 849-5842

JOB ID: CF.48

CONTROL # 21405

COMMON AREA

LAKE "A"
M.P. ELEV. = 871.0
BOTTOM ELEV. = 862.0

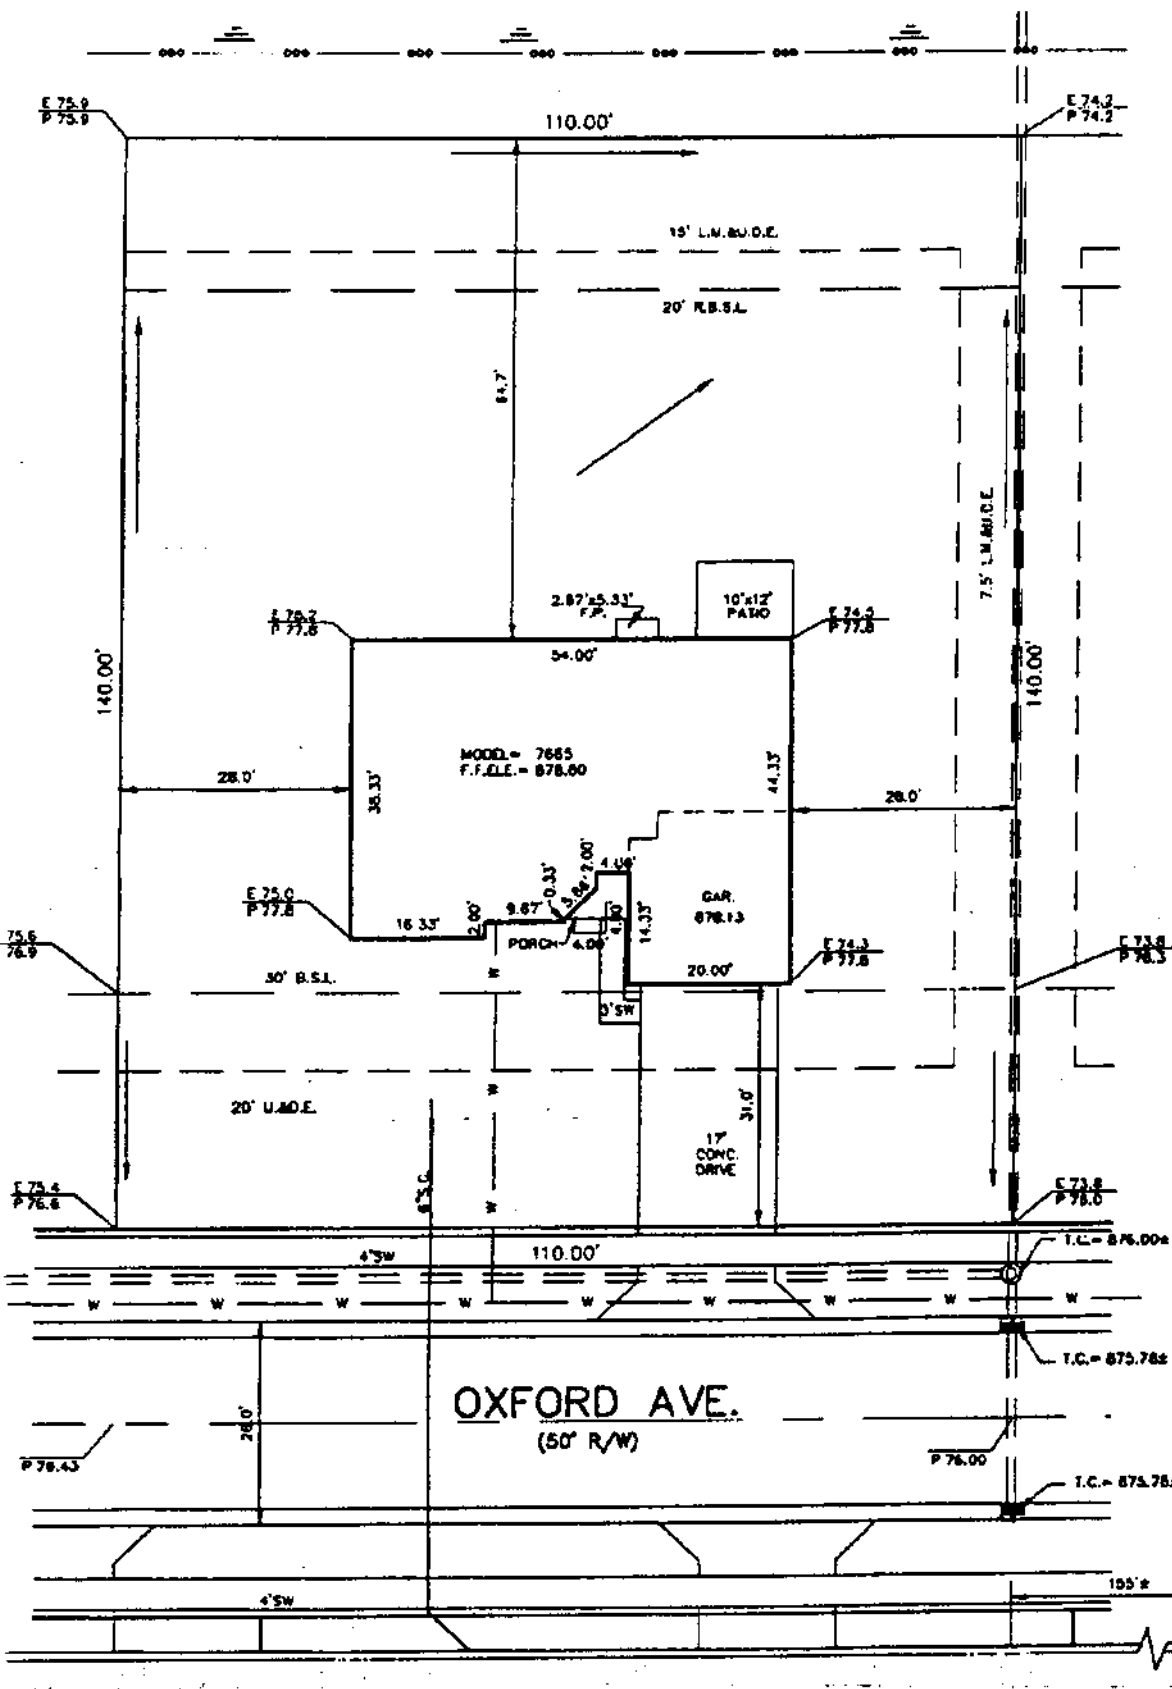

159 OXFORD AVE.



1" = 20'

LOT SIZE: 15,400 Sq. Ft.

LEGEND:
E 89.99 EXISTING GRADE (BEFORE CONST.)
P 89.99 PROPOSED GRADE (AFTER CONST.)

--- SANITARY SEWER
--- STORM SEWER
--- WATER MAIN
--- 3/4" WATER CONN.

ALL UNDERGROUND SEWERS AND UTILITIES SHOWN ARE PLOTTED BY SCALE FROM DESIGN PLANS FURNISHED BY ENGINEER. THE ACTUAL FIELD LOCATION MAY VARY.



Curtis C. Huff

LOT 48 - COUNTRY FARMS

INST. #9402164
BK. #20, PG #123-125

10/7/94 TLT
"Don't Dig Blind"
Call Two working days before you
It's the Law
1-800-392-5544

10110