

Fall Creek Regional Waste District

9378 S 650 W, P.O. Box 59, Pendleton, IN 46064

765-778-7544

Agreement for Sanitary Sewer Service

#6481

This Agreement made and entered into this 2 day of March, 2014, between Fall Creek Regional Waste District ("District") and Mustin Builders ("Applicant") regarding the provision of sanitary sewer service, and the assignment of capacity in and connection to, the District's facilities for the premises located at Pendle Point

Now therefore, the parties, in consideration of the mutual promises set out in this Agreement, the receipt and sufficiency of which is hereby acknowledged, agree as follows:

1. The Applicant agrees that all workmanship and materials shall conform to all District ordinances and the District's construction standards. District must accept and approve all work and materials before backfilling and final connection is made to the sewer mains. Any violation of this provision will cause all lines and appurtenances in violation to be removed and replaced at the Applicant's expense.
2. The District shall have the right to enter upon the Applicant's premises at all reasonable times to inspect, repair, or replace any equipment used in connection with the District's service or which has an impact on said service.
3. The Applicant shall be failure to pay any rate c termination of service to but not limited to, all att rates, capacity charges, and tap fees. The against the property and/or the will be borne by Applicant, including,
4. The District shall not be unless said damages are c result of any failure to supply service 'ity on the part of the District.
5. If there is an available sar. 1 (300) feet of the property line, the s sanitary sewer system.
6. The Applicant and District ary sewer service touches and the District and Applicant and their representatives, successors, agents, attorneys, assigns,

The parties hereto have read and fully understand the above provisions and agree to comply with said provisions.

FALL CREEK REGIONAL WASTE DISTRICT
Rebecca Lynn Hunter
Signature

APPLICANT
James E. Johnson
Signature

STATE OF INDIANA)
) SS:
COUNTY OF MADISON)

SUBSCRIBED and sworn to before me this 26 day of March, 2014

My Commission Expires:

Signature Rebecca Lynn Hunter



Commission Expires November 20, 2015

A Resident of

Hamilton County, Indiana

Rebecca Lynn Hunter, Notary Public

Printed Rebecca Lynn Hunter

Notary Public

Resident of Hamilton County


Inspector _____ Date Inspected 4-1-14 Approved ☒ Rejected _____

Reason for Rejection _____

Date Reinspected _____ Approved _____ Rejected _____

Notes:

Size Pipe 6" Type Pipe PVC 35
Basement Yes ☒ No ☒
Sump Pump Yes ☒ No ☒
Downspout to Ground Yes ☒ No ☒
Septic Tank Pumped & Filled Yes NO
Contractor BATON
Special Conditions _____
Existing Home _____
New Construction ☒

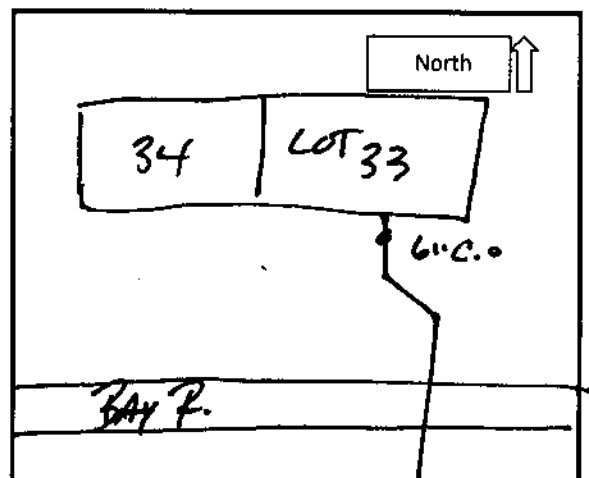

Don Moore turned permit in

Original check is printed on chemical reactive paper with fluorescent fiber content and a watermark - hold up to a light to view



MUSTIN BUILDERS, INC.
810 CENTRAL AVENUE
ANDERSON, IN 46012
PH. 765-644-8502

STAR
Financial Bank
PO Box 11409 • Fort Wayne, IN 46858-1409

302598

71-167749

Six Thousand Seven Hundred Forty

DATE

3-26-14

CHECK NO.

302598

AMOUNT

6,740.⁰⁰/₁₀₀

PAY
TO THE
ORDER
OF

FCRW

AUTHORIZED SIGNATURE

⑈ 302598 ⑈ ⑆074901672⑆

COPY