

22-27675.00
4372

FALL CREEK REGIONAL WASTE DISTRICT

9378 S 650 WEST, P.O. BOX 59, PENDLETON, IN 46064
765-778-7544

AGREEMENT FOR SANITARY SEWER SERVICE

This Agreement made and entered into this 9th day of May, 2001, between FALL CREEK REGIONAL WASTE DISTRICT ("District") and Jason Bolinger ("Applicant") regarding the provision of sanitary sewer service, and the assignment of capacity in, and connection to, the District's facilities for the premises located at Lot #109 1617 W. Quail Ct

NOW THEREFORE, the parties, in consideration of the mutual promises and sufficiency of which is hereby acknowledged, agree as follows:

1. The Applicant agrees that all workmanship and materials shall conform to the District's construction standards. District must accept and approve all work and connection is made to the sewer mains. Any violation of this provision will cause a to be removed and replaced at the Applicant's expense.
2. The District shall have the right to enter upon the Applicant's premises to inspect, repair, or replace any equipment used in connection with the District's service or which has an impact on service.
3. The Applicant shall be responsible for all monthly user rates, capacity charges, and tap fees. The failure to pay any rate charge or fee may result in a lien against the property and/or the termination of service to the property, the cost of which will be borne by Applicant, including, but not limited to, all attorney's fees and collection costs.
4. The District shall not be responsible for any damages as a result of any failure to supply service unless said damages are due to default, neglect or culpability on the part of the District.
5. If there is an available sanitary sewer within three hundred (300) feet of the property line, the property owner shall be required to connect to the District's sanitary sewer system.
6. The Applicant and District agree that the provision of sanitary sewer service touches and concerns the property and the terms of this Agreement bind the District and Applicant and their heirs, executors, administrators, personal representatives, successors, agents, attorneys, assigns, designees, and transferees.

The parties hereto have read and fully understand the above provisions and agree to comply with said provisions.

FALL CREEK REGIONAL WASTE DISTRICT

Signature Jan Carey

STATE OF INDIANA)

) SS:

COUNTY OF MADISON)

APPLICANT

Signature Jason Bolinger

SUBSCRIBED and sworn to before me this 9th day of May, 2001.

My Commission Expires:

2-20-2008

Signature Deborah L. Wilson

Printed Deborah L. Wilson

Notary Public

Resident of Madison County

INSPECTOR Be DATE INSPECTED 5-21-01 APPROVED ✓ REJECTED _____

REASON FOR REJECTION _____

DATE REINSPECTED _____ APPROVED _____ REJECTED _____

NOTES:

SIZE PIPE 6 TYPE PIPE 3.5

BASEMENT YES _____ NO X

SUMP PUMP YES _____ NO ✓

DOWNSPOUT TO GROUND YES X NO _____


SEPTIC TANK PUMPED & FILLED YES ✓ NO _____

CONTRACTOR BoHeo

SPECIAL CONDITIONS _____

EXISTING HOME _____

NEW CONSTRUCTION X

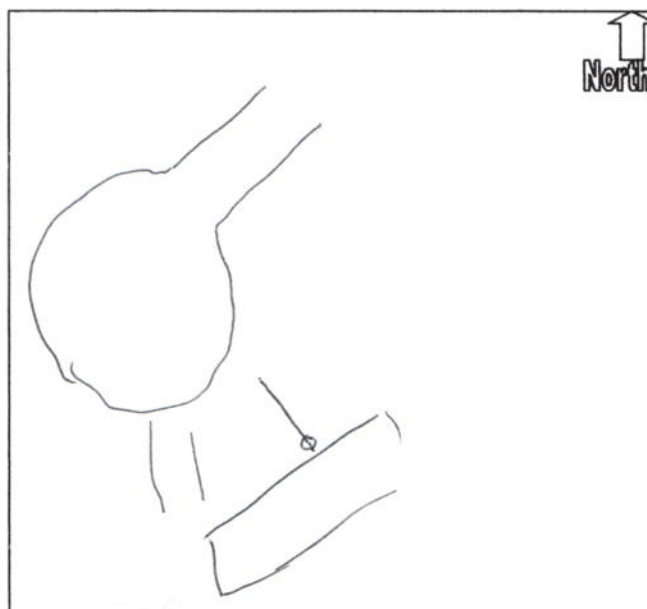



MUSTIN BUILDERS, INC.
810 CENTRAL AVENUE
ANDERSON, IN 46012
PH. 765-644-8502

KEYBANK NATIONAL ASSOCIATION
CLEVELAND, OHIO 44114

56-704-412

042445


Eight Hundred ⁰⁰/₁₀₀

DATE 5-09-01

CHECK NO. 042445 AMOUNT \$ 800.⁰⁰/₁₀₀

PAY
TO THE
ORDER
OF

F.C.R.W.

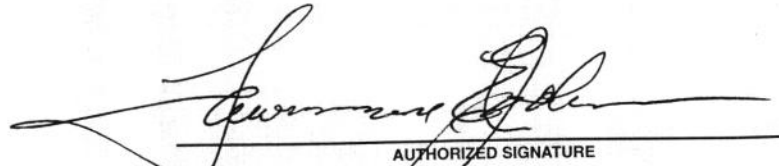
AUTHORIZED SIGNATURE

⑈042445⑈ ⑆041207040⑆00700⑈ 15984⑈