

# Fall Creek Regional Waste District

9378 S 650 W, P.O. Box 59, Pendleton, IN 46064

765-778-7544

## Agreement for Sanitary Sewer Service

#6557

This Agreement made and entered into this 11 day of March, 2016, between Fall Creek Regional Waste District ("District") and Arbor Homes ("Applicant") regarding the provision of sanitary sewer service, and the assignment of capacity in and connection to, the District's facilities for the premises located at 1418 Huntzinger Blvd. Pendleton, IN 46064

Huntzinger Farms Lot 35  
Now therefore, the parties, in consideration of the mutual promises set out in this Agreement, the receipt and sufficiency of which is hereby acknowledged, agree as follows:

1. The Applicant agrees that all workmanship and materials shall conform to all District ordinances and the District's construction standards. District must accept and approve all work and materials before backfilling and final connection is made to the sewer mains. Any violation of this provision will cause all lines and appurtenances in violation to be removed and replaced at the Applicant's expense.
2. The District shall have the right to enter upon the Applicant's premises at all reasonable times to inspect, repair, or replace any equipment used in connection with the District's service or which has an impact on said service.
3. The Applicant shall be responsible for all monthly user rates, capacity charges, and tap fees. The failure to pay any rate charge or fee may result in a lien against the property and/or the termination of service to the property, the cost of which will be borne by Applicant, including, but not limited to, all attorney's fees and collection costs.
4. The District shall not be responsible for any damages as a result of any failure to supply service unless said damages are due to default, neglect or culpability on the part of the District.
5. If there is an available sanitary sewer within three hundred (300) feet of the property line, the property owner shall be required to connect to the District's sanitary sewer system.
6. The Applicant and District agree that the provision of sanitary sewer service touches and concerns the property and the terms of this Agreement bind the District and Applicant and their heirs, executors, administrators, personal representatives, successors, agents, attorneys, assigns, designees, and transferees.

The parties hereto have read and fully understand the above provisions and agree to comply with said provisions.

FALL CREEK REGIONAL WASTE DISTRICT

Signature

STATE OF INDIANA )

) SS:

COUNTY OF MADISON )

APPLICANT

Signature

SUBSCRIBED and sworn to before me this 11 day of March, 2016



Signature

Printed

Notary Public

Resident of Madison County

\*\*\*\*\*


Inspector Don Date Inspected 4-1-16 Approved ☒ Rejected ☐

Reason for Rejection \_\_\_\_\_

Date Reinspected \_\_\_\_\_ Approved ☐ Rejected ☐

Notes:

Size Pipe 6" Type Pipe PVC 35  
Basement Yes ☐ No ☒  
Sump Pump Yes ☐ No ☒  
Downspout to Ground Yes ☒ No ☐  
Septic Tank Pumped & Filled Yes ☒ No ☐  
Contractor DR. WATSON  
Special Conditions \_\_\_\_\_  
Existing Home ☒  
New Construction ☐

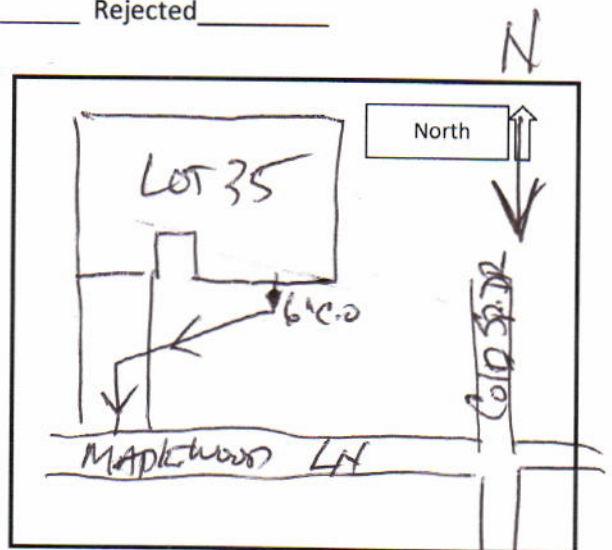

1 picture attached





Huntzinger Farms Lot 35

1108 Huntzinger Blvd



ARBOR HOMES, L.L.C.  
PERMIT ACCOUNT6626 E. 75TH STREET, SUITE 400  
INDIANAPOLIS, IN 4625071-65/749  
First Merchants Bank  
www.firstmerchants.com

028231

DATE 3/3/2016

PAY  
TO THE  
ORDER OF Fall Creek Regional Waste District

\$ 3,370.00

Three Thousand Three Hundred And Seventy Dollars And 0/100

DOLLARS

FOR HUNTZ 35



BY:

NOT VALID FOR AMOUNTS OVER \$10,000

AUTHORIZED SIGNATURE

See Rec # 010448