

22-21551-00

## FALL CREEK REGIONAL WASTE DISTRICT

No 6080

9378 S 650 WEST, P.O. BOX 59, PENDLETON, IN 46064

765-778-7544

Cookston  
Joel

## AGREEMENT FOR SANITARY SEWER SERVICE

This Agreement made and entered into this 23rd day of August, 2006, between FALL CREEK REGIONAL WASTE DISTRICT ("District") and Robert Taylor, Inc. ("Applicant") regarding the provision of sanitary sewer service, and the assignment of capacity in, and connection to, the District's facilities for the premises located at 10+8, Lantern Meadows

161 Woodland Drive

**NOW THEREFORE**, the parties, in consideration of the mutual promises set out in this Agreement, the receipt and sufficiency of which is hereby acknowledged, agree as follows:

1. The Applicant agrees that all workmanship and materials shall conform to all District ordinances and the District's construction standards. District must accept and approve all work and materials before backfilling and final connection is made to the sewer mains. Any violation of this provision will cause all lines and appurtenances in violation to be removed and replaced at the Applicant's expense.

2. The District shall have the right to enter upon the property to inspect, repair, or replace any equipment used in connection with the service.

3. The Applicant shall be responsible for all costs of the service. The failure to pay any rate charge or fee may result in a lien against the property, the cost of which will be borne by Applicant.

4. The District shall not be responsible for damages to the property unless said damages are due to default, neglect or culpable action of the District.

5. If there is an available sanitary sewer within three hundred (300) feet of the property line, the property owner shall be required to connect to the District's sanitary sewer system.

6. The Applicant and District agree that the provision of sanitary sewer service touches and concerns the property and the terms of this Agreement bind the District and Applicant and their heirs, executors, administrators, personal representatives, successors, agents, attorneys, assigns, designees, and transferees.

The parties hereto have read and fully understand the above provisions and agree to comply with said provisions.

FALL CREEK REGIONAL WASTE DISTRICT  
Deborah L. Wilson  
Signature

APPLICANT  
Cindy Cottenson  
Signature

STATE OF INDIANA )  
COUNTY OF MADISON ) SS:

SUBSCRIBED and sworn to before me this 23rd day of August, 2006.

My Commission Expires: 2-20-2008

Signature Deborah L. Wilson  
Printed Deborah L. Wilson

Notary Public  
Resident of Madison County

\*\*\*\*\*

INSPECTOR SN DATE INSPECTED 5/9/07 APPROVED ✓ REJECTED \_\_\_\_\_

REASON FOR REJECTION \_\_\_\_\_

DATE REINSPECTED \_\_\_\_\_ APPROVED \_\_\_\_\_ REJECTED \_\_\_\_\_

NOTES:  
SIZE PIPE 6" TYPE PIPE 35

BASEMENT YES \_\_\_\_\_ NO \_\_\_\_\_

SUMP PUMP YES \_\_\_\_\_ NO \_\_\_\_\_

DOWNSPOUT TO GROUND YES \_\_\_\_\_ NO \_\_\_\_\_


SEPTIC TANK PUMPED & FILLED YES \_\_\_\_\_ NO \_\_\_\_\_

CONTRACTOR Bob Taylor

SPECIAL CONDITIONS \_\_\_\_\_

EXISTING HOME \_\_\_\_\_

NEW CONSTRUCTION ✓

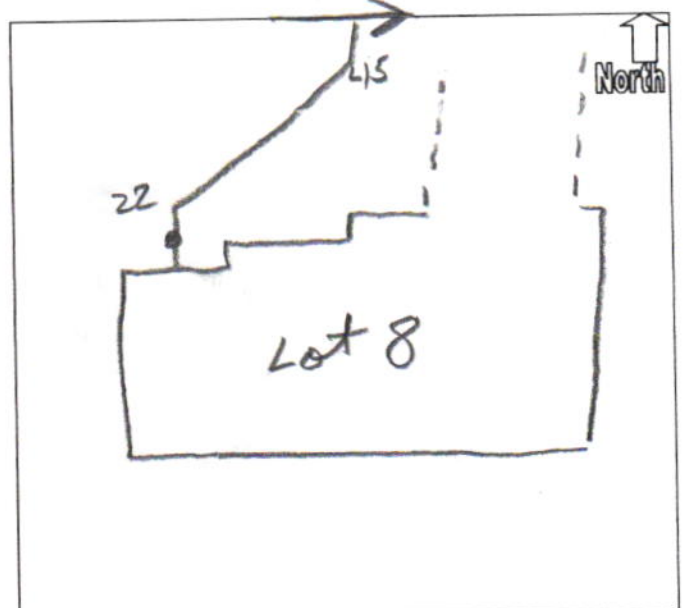



ROBERT G. TAYLOR, INC.

8880 SOUTH CR. 800 WEST  
DALEVILLE, IN 47334

FIRST MERCHANTS BANK

71-65/749

3495

PAY

3495

DATE  
Aug 23, 2006

AMOUNT  
\*\*\*\*\$2,635.00

Memo:

Two Thousand Six Hundred Thirty-Five and 00/100 Dollars

Fall Creek Regional Waste Dist

P.O. Box 59

Pendleton, IN 46064

TO THE  
ORDER  
OF

ROBERT G. TAYLOR, INC.

*Cindy L. Costen*  
AUTHORIZED SIGNATURE

⑈003495⑈ ⑆074900657⑆