



FALL CREEK REGIONAL WASTE DISTRICT

9378 S. 650 West PO Box 59
Pendleton, IN 46064-0059 778-7544

add order
or file

Staley Homes

22-27680

Nº 2742

APPLICATION FOR SEWER PERMIT

Date 3/28/00

Permit Void 90 days from Date of Issuance

Owner Name Kramer Jim Meyers

Property Address 1627 W Quail Court

Lot # 111, HHE (110) P.O. Box _____

Town Pendleton, IN Zip Code 46064

Phone _____ City Water _____ Well ☒

\$ 400.00 Tap on Fee Paid

\$ N/A Inspection fee paid

Application is hereby made for connection to the Fall Creek Regional Waste District Sewer System for the above listed property - Permit Type: Residential ☒, Commercial _____, Industrial _____, or Governmental/Institutional _____. User Information _____.

All workmanship and materials shall conform to the standards of the District Ordinance as described in Ordinance 84-2 and 84-3 as amended. Acceptance and approval must be made by the District inspector or his duly authorized representative before backfilling and final connection is made to the main sewer lines. Any violation of applicable regulations will cause all lines and appurtenances in violation to be removed and replaced at the owners expense.

The Fall Creek Regional Waste District is responsible for the inspection, approval of materials, and installation techniques only. All costs for materials and installation and any liabilities resulting from same is the sole responsibility of the property owner.

I have read and fully understand the above provisions and agree to comply by said provisions.

Jim Staley

APPLICANT(S) SIGNATURE

INSPECTOR TIM

Date inspected 5-16-00 Approved ☒ Rejected _____

Reason for rejection _____

Date reinspected _____ Approved _____ Rejected _____

Notes:

Size Pipe 6"

Type Pipe SDR 35

Basement Yes _____ No ☒

Sump Pump Yes _____ No ☒

Downspout to Ground Yes _____ No _____


Septic Tank Pumped & filled Yes _____ No _____

Contractor MARK SMITH

Special Conditions _____

Existing Home _____

New Construction ☒

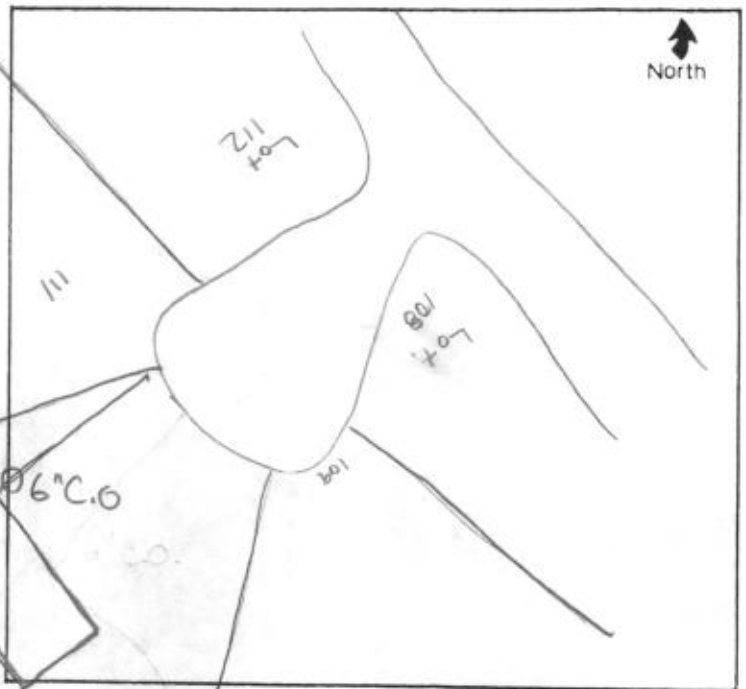

TERRY STAILEY
5521 IDELLA DR.
ANDERSON, IN 46013

71-65/749
6013198

No

148

Date *3-28-00*



F.C.R.W.D

\$ *400* ^{*00*}/_{*100*}

FOUR HUNDRED

^{*00*}/_{*100*}

DOLLARS

Security features
included
Details on back



First Merchants Bank
First Merchants Bank, N.A. Muncie, Indiana

Memo

TRAMER SEWAGE
PERMIT

Terry Stailey

MP

⑆074900657⑆

601 319 811 0148

MEDALLION