

765-778-7544

16. 60476.99

3 day of February, 2010

1628 FAIRWEATHER DRIVE

- The parties hereto have read and fully understand the above provisions and agree to comply with said provisions.

APPLICANT
Signature

[illegible]

3 day of February, 2010

Signature Rebecca L. Hunter
Printed Rebecca L. Hunter
Notary Public
Resident of Madison County Hamilton Co.

INSPECTOR DM DATE INSPECTED 2-19-10 APPROVED ✓ REJECTED

REASON FOR REJECTION

DATE REINSPECTED	APPROVED	REJECTED
------------------	----------	----------

NOTES: SIZE PIPE 6" TYPE PIPE 5DR35

BASEMENT YES NO

SUMP PUMP YES NO

DOWNSPOUT TO GROUND YES NO


SEPTIC TANK PUMPED & FILLED YES NO

CONTRACTOR **SAMCO**

SPECIAL CONDITIONS

EXISTING HOME

NEW CONSTRUCTION

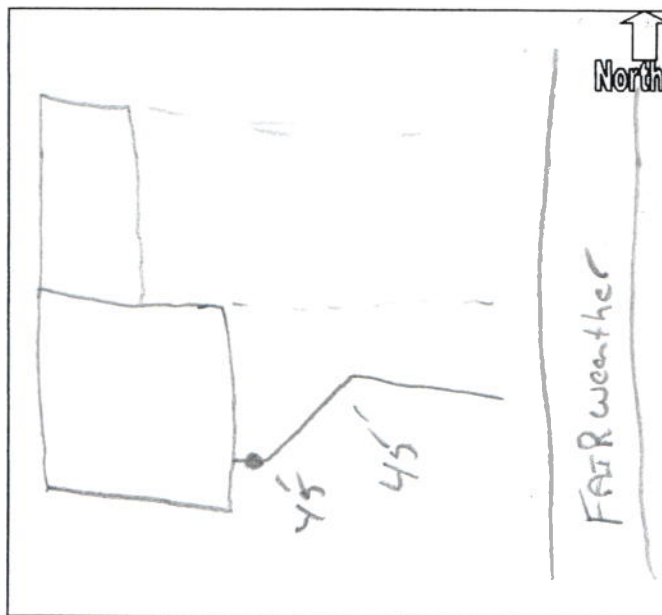

CORONADO RIDGE DEVELOPMENT CORP.

08/01

P.O. BOX 647
WESTFIELD, IN 46074
PH. 317-984-8689

1/29/10

PAY TO THE
ORDER OF

Fall Creek Regional Waste

\$ **3,370.00


Three Thousand Three Hundred Seventy and 00/100*****

DOLLARS

Fall Creek Regional Waste
P.O. Box 59
Pendleton, IN 46064-0059

COPY

MEMO

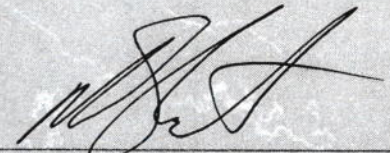

AUTHORIZED SIGNATURE

MP

⑈021510⑈ ⑆086300012⑆ 119413046⑈

Security Features Included