

22-27685.00



FALL CREEK REGIONAL WASTE DISTRICT  
9378 S. 650 West PO Box 59  
Pendleton, IN 46064-0059 778-7544

Staley Homes

No 2780

APPLICATION FOR SEWER PERMIT

Date \_\_\_\_\_  
Permit Void 90 days from Date of Issuance  
Owner Name Kent Kramer  
Property Address 1630 Quail Court  
Lot # 111 P.O. Box \_\_\_\_\_  
Town Pendleton, IN Zip Code 46064  
Phone \_\_\_\_\_ City Water \_\_\_\_\_ Well ☒  
\$ 400.00 Tap on Fee Paid  
\$ \_\_\_\_\_ Inspection fee paid

Application is hereby made for connection to the Fall Creek Regional Waste District Sewer System for the above listed property - Permit Type: Residential ☒, Commercial \_\_\_\_\_, Industrial \_\_\_\_\_, or Governmental/Institutional \_\_\_\_\_. User Information \_\_\_\_\_.

All workmanship and materials shall conform to the standards of the District Ordinance as described in Ordinance 84-2 and 84-3 as amended. Acceptance and approval must be made by the District inspector or his duly authorized representative before backfilling and final connection is made to the main sewer lines. Any violation of applicable regulations will cause all lines and appurtenances in violation to be removed and replaced at the owners expense.

The Fall Creek Regional Waste District is responsible for the inspection, approval of materials, and installation techniques only. All costs for materials and installation and any liabilities resulting from same is the sole responsibility of the property owner.

I have read and fully understand the above provisions and agree to comply by said provisions.

APPLICANT(S) SIGNATURE


\*\*\*\*\*

INSPECTOR Tim

Date inspected 3-27-00 Approved ☒ Rejected \_\_\_\_\_  
Reason for rejection \_\_\_\_\_

Date reinspected \_\_\_\_\_ Approved \_\_\_\_\_ Rejected \_\_\_\_\_

Notes:  
Size Pipe 6"  
Type Pipe SDR 35  
Basement Yes \_\_\_\_\_ No ☒  
Sump Pump Yes \_\_\_\_\_ No ☒  
Downspout to Ground Yes \_\_\_\_\_ No \_\_\_\_\_  
Septic Tank Pumped & filled Yes \_\_\_\_\_ No \_\_\_\_\_  
Contractor MARK SMITH  
Special Conditions \_\_\_\_\_  
Existing Home \_\_\_\_\_  
New Construction ☒

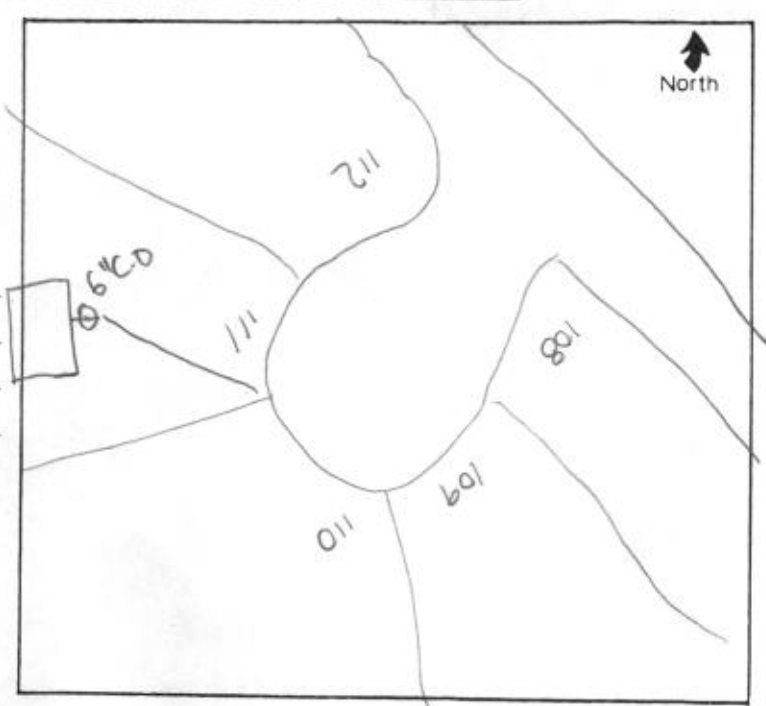





FALL CREEK REGIONAL WASTE DISTRICT

9378 S. 650 West PO Box 59  
Pendleton, IN 46064-0059 778-7544

add order  
on file

Stailley Homes

APPLICATION FOR SEWER PERMIT

No 2741

Date

3/28/00

Permit Void 90 days from Date of Issuance

Owner Name

Jim Meyers Kramer

Property Address

1627 W Quail Court

Lot #

111

P.O. Box

Town

Pendleton

, IN

Zip Code

46064

Phone

City Water

Well

✓

\$

400.00

Tap on Fee Paid

\$

N/A

Inspection fee paid

Application is hereby made for connection to the Fall Creek Regional Waste District Sewer System for the above listed property - Permit Type: Residential ☒, Commercial ☐, Industrial ☐, or Governmental/Institutional ☐. User Information

All workmanship and materials shall conform to the standards of the District Ordinance as described in Ordinance 84-2 and 84-3 as amended. Acceptance and approval must be made by the District inspector or his duly authorized representative before backfilling and final connection is made to the main sewer lines. Any violation of applicable regulations will cause all lines and appurtenances in violation to be removed and replaced at the owners expense.

The Fall Creek Regional Waste District is responsible for the inspection, approval of materials, and installation techniques only. All costs for materials and installation and any liabilities resulting from same is the sole responsibility of the property owner.

I have read and fully understand the above provisions and agree to comply by said provisions.

APPLICANT(S) SIGNATURE

INSPECTOR

Tim

Date inspected 3-27-2000

Approved

✓

Rejected

Reason for rejection

Date reinspected

Approved

Rejected

Notes:

Size Pipe 6" "

Type Pipe SDR35

Basement Yes No ✓

Sump Pump Yes No ✓

Downspout to Ground Yes No


Septic Tank Pumped & filled Yes No

Contractor MARK Smith

Special Conditions

Existing Home

New Construction ✓

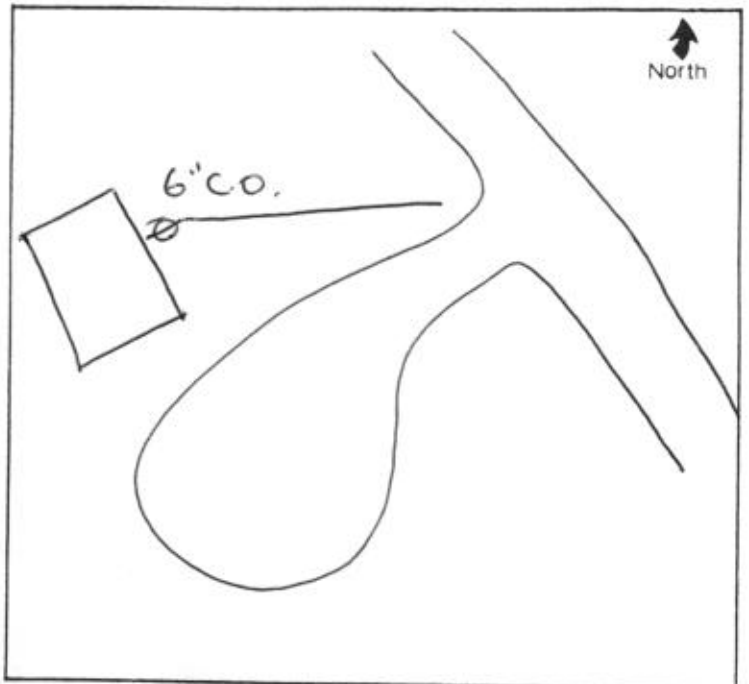



TERRY STAILEY  
5521 IDELLA DR.  
ANDERSON, IN 46013

71-65/749  
6013198

No.

149

Date 3-28-00



FCRWD

FOUR HUNDRED

\$ 400 <sup>00</sup>/<sub>100</sub>

DOLLARS

Security features  
included  
Deposit on back



**First Merchants Bank**  
First Merchants Bank, N.A. Muncie, Indiana

Memo MEYERS SEWAGE  
PERMIT

Terry Stailey

⑆074900657⑆

601 319 811 0149

MEDALLION