

#6492

This Agreement made and entered into this 16 day of July, 2014, between Fall Creek Regional Waste District ("District") and Pyatt Builders ("Applicant") regarding the provision of sanitary sewer service, and the assignment of capacity in and connection to, the District's facilities for the premises located at Huntzinger Farms Lot 9.

1. The Applicant agrees that all workmanship and materials shall conform to all District ordinances and the District's construction standards. District must accept and approve all work and materials before backfilling and final connection is made to the sewer mains. Any violation of this provision will cause all lines and appurtenances in violation to be removed and replaced at the Applicant's expense.
2. The District shall have the right to enter upon the Applicant's premises at all reasonable times to inspect, repair, or replace any equipment used in connection with the District's service or which has an impact on said service.
3. The Applicant shall be responsible for all monthly user rates, capacity charges, and tap fees. The failure to pay any rate charge or fee may result in a lien against the property and/or the termination of service to the property, the cost of which will be borne by Applicant, including, but not limited to, all attorney's fees and collection costs.
4. The District shall not be responsible for any damages as a result of any failure to supply service unless said damages are due to default, neglect or culpability on the part of the District.
5. If there is an available sanitary sewer within three hundred (300) feet of the property line, the property owner shall be required to connect to the District's sanitary sewer system.
6. The Applicant and District agree that the provision of sanitary sewer service touches and concerns the property and the terms of this Agreement bind the District and Applicant and their heirs, executors, administrators, personal representatives, successors, agents, attorneys, assigns, designees, and transferees.

FALL CREEK REGIONAL WASTE DISTRICT
Signature

APPLICANT
Signature

SUBSCRIBED and sworn to before me this 16 day of July, 2014

Signature Rebecca Lynne Hunt

Printed Rebecca Lynn Hunter

Inspector SN Date Inspected 7/16/14 Approved ✓ Rejected

Reason for Rejection _____
 Date Reinspected _____ Approved _____ Rejected _____

Size Pipe 6" Type Pipe 35

Basement Yes No

Sump Pump Yes ☐ No ☐

Downspout to Ground Yes No


Septic Tank Pumped & Filled Yes No

Contractor Pyatt Builders

Special Conditions _____

Existing Home

New Construction

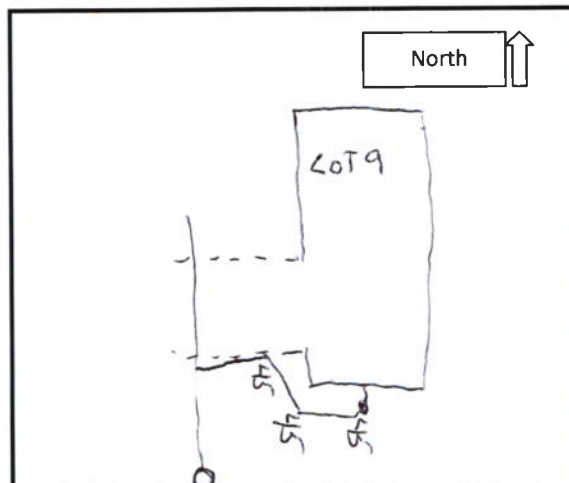

HOLD TO LIGHT TO VIEW WATERMARK IN PAPER HEAT SENSITIVE RED IMAGE DISAPPEARS WITH HEAT DETECTION CIRCLE REVEALS A LOCK WHEN TESTED

9207

PYATT BUILDERS

136 W. CARMEL DR.
CARMEL, IN 46032

BMO Harris Bank
BMO Harris Bank N.A.
Chicago, Illinois

2-2566-710

E23456789 Check Fraud
Protection for Business

7/16/14

THE
OF FC RWD

\$ 3370.00

THREE THOUSAND THREE HUNDRED SEVENTY AND

⁰⁰/₁₀₀ DOLLARS

HF9 SEWER



[Signature]
AUTHORIZED SIGNATURE

Security features. Details on back.

⑈009207⑈ ⑆071025661⑆ 4811347323⑈

100