



# FALL CREEK REGIONAL WASTE DISTRICT

Box 44, Pendleton, Indiana 46064

add order on file

Est Comp. April 92

222 3290.00

## APPLICATION FOR SEWER PERMIT

Nº 001834

Permit No. \_\_\_\_\_ Date 2/28/92  
Permit Void 90 days from Date of Issuance  
Owner Name David Wright  
Property Address 165 W US 36  
Lot # 14 P.O. Box \_\_\_\_\_  
Town Pendleton, IN Zip Code 46064  
Phone \_\_\_\_\_ Water Meter \_\_\_\_\_

\$ 3,005.00 Tap on Fee Paid

\$ 25.00 Inspection fee paid

Application is hereby made for connection to the Fall Creek Regional Waste District Sewer System for the above listed property - Permit Type: Residential ☒, Commercial \_\_\_\_\_, Industrial \_\_\_\_\_, or Governmental/Institutional \_\_\_\_\_. User Information \_\_\_\_\_

All workmanship and materials shall conform to the standards of the District Ordinance as described in Ordinance 84-2 and 84-3 as amended. Acceptance and approval must be made by the District inspector or his duly authorized representative before backfilling and final connection is made to the main sewer lines. Any violation of applicable regulations will cause all lines and appurtenances in violation to be removed and replaced at the owners expense.

The Fall Creek Regional Waste District is responsible for the inspection, approval of materials, and installation techniques only. All costs for materials and installation and any liabilities resulting from same is the sole responsibility of the property owner.

I have read and fully understand the above provisions and agree to comply by said provisions.

David L Wright  
APPLICANT(S) SIGNATURE

\*\*\*\*\*

INSPECTOR TM


Date inspected 3-15-92 Approved ☒ Rejected \_\_\_\_\_

Reason for rejection \_\_\_\_\_

Date reinspected \_\_\_\_\_ Approved \_\_\_\_\_ Rejected \_\_\_\_\_

### Notes:

Size Pipe 4"  
Type Pipe Pvc Sch. 40  
Basement Yes ☒ No \_\_\_\_\_  
Sump Pump Yes ☒ No \_\_\_\_\_  
Downspout to Ground Yes ☒ No \_\_\_\_\_  
Septic Tank Pumped & filled Yes ☒ No \_\_\_\_\_  
Contractor SELF  
Special Conditions \_\_\_\_\_

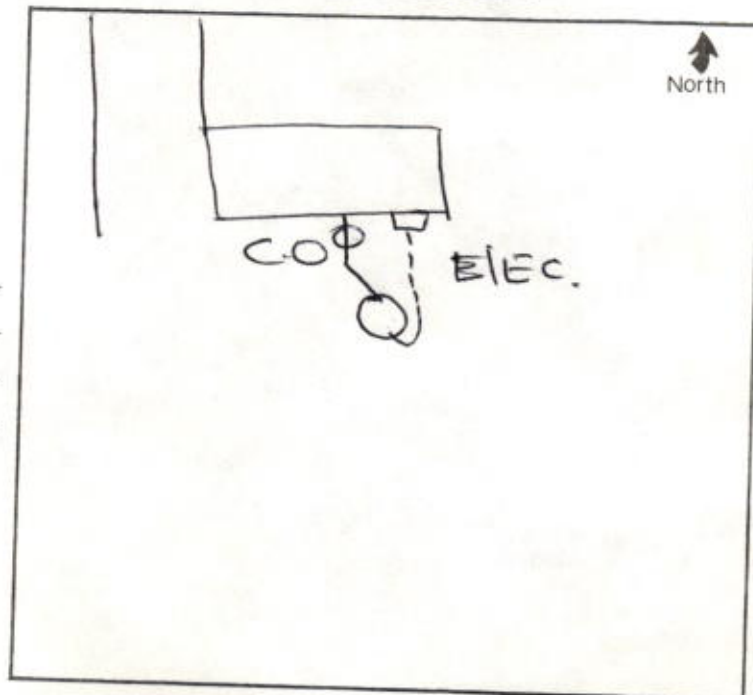



FALL CREEK REGIONAL WASTE DISTRICT

Box 44, Pendleton, Indiana 46054

Handwritten notes at top left: 'also order on file' and 'Box 44 Pendleton, Ind 46054'.

222 3290 00

1% 001834

APPLICATION FOR SEWER PERMIT

Form fields for permit application including: Permit No., Date, Name, Address, City, State, Zip, Phone, and Fees (Inspection fee, Tap on fee paid).

Application is hereby made for connection to the Fall Creek Regional Waste District sewer system for the above listed property - Permit Type: Residential, Commercial, Industrial, or Governmental.


All workmanship and materials shall conform to the standards of the District Ordinance as described in Ordinances 84-1 and 84-3 as amended. Acceptance and approval must be made by the District Inspector or his duly authorized representative before backfilling and final connection is made to the main sewer lines.

The Fall Creek Regional Waste District is responsible for the inspection, approval of materials, and installation techniques only. All costs for materials and installation and any liabilities resulting from same is the sole responsibility of the property owner.

I have read and fully understand the above provisions and agree to comply with said provisions.

Signature line for the property owner.

Form fields for inspection status: Date inspected, Reason for rejection, Date reinspected, Approved, Rejected.

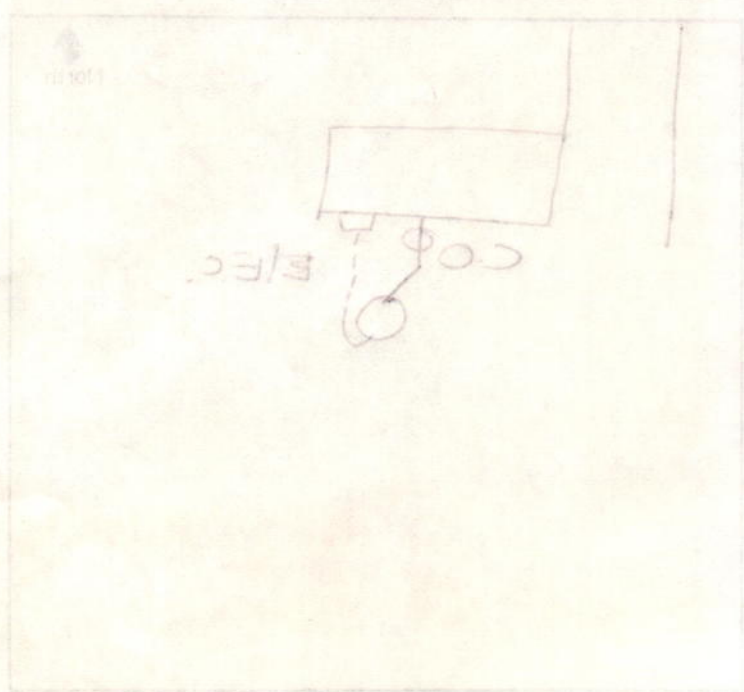

Form fields for additional details: Sewer type, Depth to ground, Backflow prevention, and Special Conditions.