







1684 Maplewood LN Huntzinger Farms Lot 58


2-14-17



1684 Maplewood LN Hunzinger Farms Lot 58 2-14-17





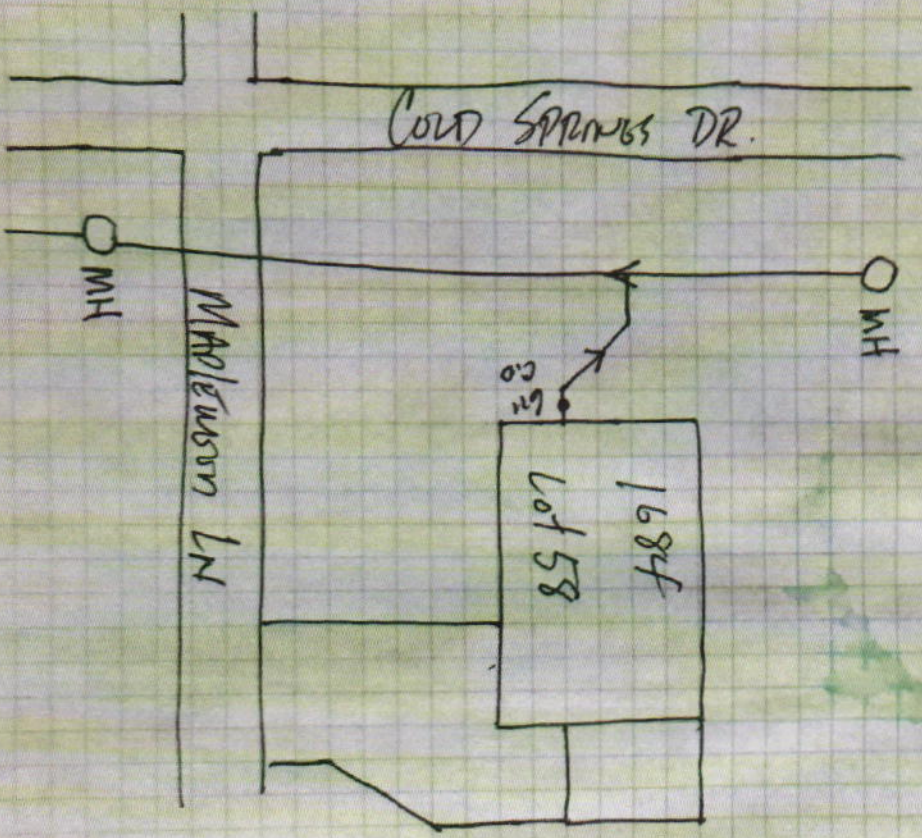

2-14-17  
Huntz Jr.  
Dr. Watson & Co.



ARBOR HOMES, L.L.C.

PERMIT ACCOUNT

6626 E. 75TH STREET, SUITE 400  
INDIANAPOLIS, IN 46250

71-65/749

First Merchants Bank  
www.firstmerchants.com

029774

DATE 11/1/2016

PAY  
TO THE  
ORDER OF

Fall Creek Regional Waste District

\$ 3,370.00

Three Thousand Three Hundred And Seventy Dollars And 0/100

DOLLARS

FOR

HUNTZ 58



BY:

NOT VALID FOR AMOUNTS OVER \$10,000

AUTHORIZED SIGNATURE

Rec # 010552