

FALL CREEK REGIONAL WASTE DISTRICT

No 5801

9378 S 650 WEST, P.O. BOX 59, PENDLETON, IN 46064
765-778-7544

22-27475.00

AGREEMENT FOR SANITARY SEWER SERVICE

This Agreement made and entered into this 4th day of October, 2005, between FALL CREEK REGIONAL WASTE DISTRICT ("District") and Terry Stailey ("Applicant") regarding the provision of sanitary sewer service, and the assignment of capacity in, and connection to, the District's facilities for the premises located at AHE 104 153 1692 W Mink Court

NOW THEREFORE, the parties, in consideration of the mutual promises set out in this Agreement, the receipt and sufficiency of which is hereby acknowledged, agree as follows:

1. The Applicant agrees that all workmanship and materials shall conform to all District ordinances and the District's construction standards. District must accept and approve all work and materials before backfilling and final connection is made to the sewer mains. Any violation of this provision will cause all lines and appurtenances in violation to be removed and replaced at the Applicant's expense.
2. The District shall have the right to enter upon the Applicant's premises at all reasonable times to inspect, repair, or replace any equipment used in connection with the District's service or which has an impact on said service.
3. The Applicant shall be responsible for all monthly user rates, capacity charges, and tap fees. The failure to pay any rate charge or fee may result in a lien against the property and/or the termination of service to the property, the cost of which will be borne by Applicant, including, but not limited to, all attorney's fees and collection costs.
4. The District shall not be responsible for any damages as a result of any failure to supply service unless said damages are due to default, neglect or culpability on the part of the District.
5. If there is an available sanitary sewer within three hundred (300) feet of the property line, the property owner shall be required to connect to the District's sanitary sewer system.
6. The Applicant and District agree that the provision of sanitary sewer service touches and concerns the property and the terms of this Agreement bind the District and Applicant and their heirs, executors, administrators, personal representatives, successors, agents, attorneys, assigns, designees, and transferees.

The parties hereto have read and fully understand the above provisions and agree to comply with said provisions.

FALL CREEK REGIONAL WASTE DISTRICT
Deborah L. Wilson
Signature

APPLICANT
Terry Stailey
Signature

STATE OF INDIANA)
) SS:
COUNTY OF MADISON)

SUBSCRIBED and sworn to before me this 4th day of October, 2005.

My Commission Expires:
2-20-2008

Signature Deborah L. Wilson
Printed Deborah L. Wilson

Notary Public
Resident of Madison County

INSPECTOR Tim DATE INSPECTED 2-6-06 APPROVED ☒ REJECTED ☐

REASON FOR REJECTION _____

DATE REINSPECTED _____ APPROVED _____ REJECTED _____

NOTES:
SIZE PIPE 6" TYPE PIPE SOR35

BASEMENT YES ☒ NO ☐

SUMP PUMP YES ☐ NO ☒

DOWNSPOUT TO GROUND YES ☒ NO ☐


SEPTIC TANK PUMPED & FILLED YES ☐ NO ☐

CONTRACTOR BL Brown

SPECIAL CONDITIONS 4" Conduit in the way

EXISTING HOME ☐

NEW CONSTRUCTION ☒

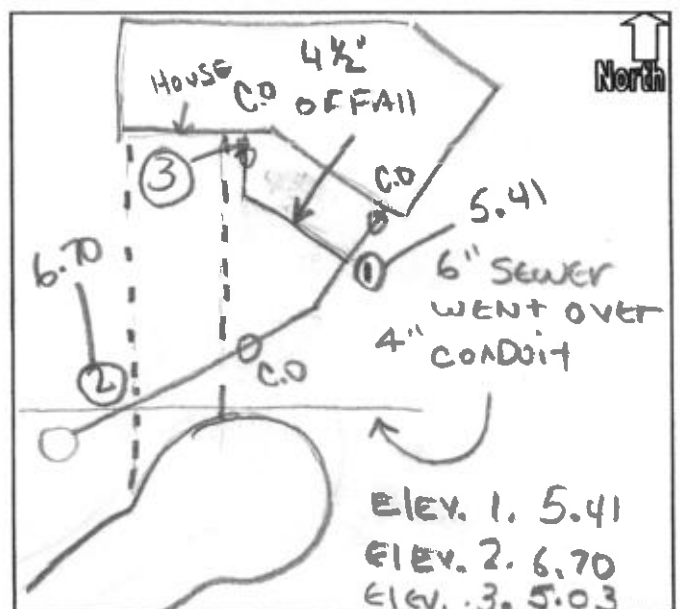

TERRY L. STAILEY
DIANE K. STAILEY
14300 W. 2ND STREET
DALEVILLE, IN 47334

71-553/749
0000313211

No. 2066

DATE 10-4-05

Pay to the order of

F.C.R.U.D.

\$ 475⁰⁰

FOUR HUNDRED SEVENTY FIVE -

00/100 DOLLARS



Security Features
Included
Details on Back



Madison
Community Bank

Permits for lot 153
HICKORY HILLS EAST

Terry Stailey

MP

⑆074905539⑆0000313211⑆

2066

ANTIQUE WATERCOLORS

new top 6.70

top 7.63

house 5.03

fall 2' 7 1/4"

(1' 5 3/4" of play)

