Fall Creek Regional Waste District 9378 S 650 W, P.O. Box 59, Pendleton, IN 46064 765-778-7544 Agreement for Sanitary Sewer Service


This Agreement made and entered into this 2 day of <u>April</u>, 20 10 between Fall Creek Regional Waste District ("District") and <u>Salverthorne</u> Homes ("Applicant") regarding the provision of sanitary sewer service, and the assignment of capacity in and connection to, the District's facilities for the premises located at <u>Hickory Hiks</u> East Lot 152. Now therefore, the parties, in consideration of the mutual promises set out in this Agreement, the

receipt and sufficiency of which is hereby acknowledged, agree as follows:

- 1. The Applicant agrees that all workmanship and materials shall conform to all District ordinances and the District's construction standards. District must accept and approve all work and materials before backfilling and final connection is made to the sewer mains. Any violation of this provision will cause all lines and appurtenances in violation to be removed and replaced at the Applicant's expense.
- 2. The District shall have the right to enter upon the Applicant's premises at all reasonable times to inspect, repair, or replace any equipment used in connection with the District's service or which has an impact on said service.
- 3. The Applicant shall be responsible for all monthly user rates, capacity charges, and tap fees. The failure to pay any rate charge or fee may result in a lien against the property and/or the termination of service to the property, the cost of which will be borne by Applicant, including, but not limited to, all attorney's fees and collection costs.
- 4. The District shall not be responsible for any damages as a result of any failure to supply service unless said damages are due to default, neglect or culpability on the part of the District.
- 5. If there is an available sanitary sewer within three hundred (300) feet of the property line, the property owner shall be required to connect to the District's sanitary sewer system.
- 6. The Applicant and District agree that the provision of sanitary sewer service touches and concerns the property and the terms of this Agreement bind the District and Applicant and their heirs, executors, administrators, personal representatives, successors, agents, attorneys, assigns, designees, and transferees.

The parties hereto have read and fully understand the above provisions and agree to comply with said provisions.

FALL CREEK REGIONAL WASTE DISTRICT	Signature 25 opp
STATE OF INDIANA)) SS: COUNTY OF MADISON)	
SUBSCRIBED and sworn to before me this $\partial 2$ day of \underline{PPri} , 2016	
HAMILTON COUNTY N	Decca Lynn Honter ebecca Lynn Honter otary Public esident of 17am. 100 County
Notes:	Rejected Rejected
Size Pipe <u>G</u> Type Pipe <u>35</u> Basement <u>Yes No</u> Sump Pump <u>Yes No</u> Downspout to Ground <u>Yes No</u> Septic Tank Pumped & Filled <u>Yes No</u> Contractor <u>DR</u> <u>Warson</u> Special Conditions Existing Home <u>New Construction</u>	North HS HS ED
	2 pictures attached

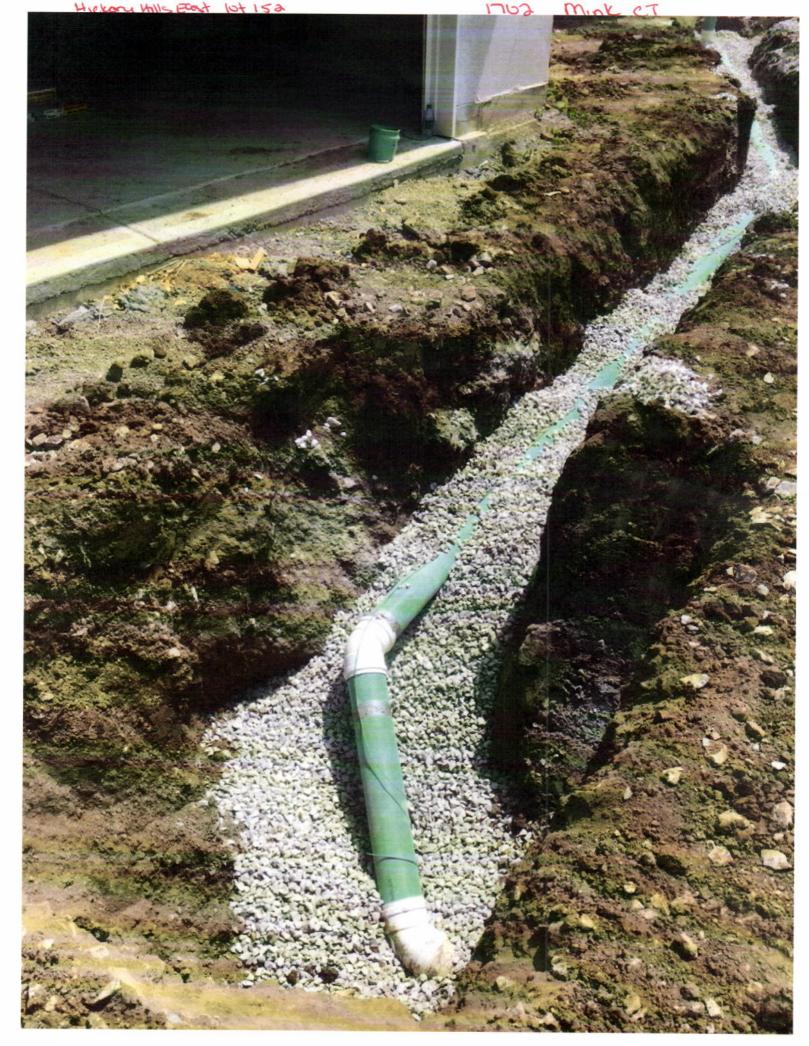



001053 71-65/749 First Merchants Bank SILVERTHORNE HOMES, LLC PERMIT ACCOUNT 6626 E. 75TH STREET, SUITE 400 INDIANAPOLIS, IN 46250 4-22-16 DATE PAY TO THE ORDER OF PAY TO THE ORDER OF Fall Creek Regional Weste Distric \$ DOLLARS NOT VALID FOR AMOUNTS OVER \$10,000 FSL 960 FOR SENSITIE BY: 5 AUTHORIZED ENATURE PER TO VE 11 .

1