

#6482

765-778-7544

Agreement for Sanitary Sewer Service

Now therefore, the parties, in consideration of the mutual promises set out in this Agreement, the receipt and sufficiency of which is hereby acknowledged, agree as follows:

1. The Applicant agrees that all workmanship and materials shall conform to all District ordinances and the District's construction standards. District must accept and approve all work and materials before backfilling and final connection is made to the sewer mains. Any violation of this provision will cause all lines and appurtenances in violation to be removed and replaced at the Applicant's expense.
2. The District shall have the right to enter upon the Applicant's premises at all reasonable times to inspect, repair or replace any sewer lines or appurtenances used in connection with the District's service or which has an impact on the District's service.
3. The Applicant agrees to pay the District for the monthly user rates, capacity charges, and tap fees. The failure to pay these fees shall result in a lien against the property and/or the cost of which will be borne by Applicant, including, but not limited to, collection costs.
4. The District shall not be liable for any damages as a result of any failure to supply service except in the event of gross negligence or culpability on the part of the District.
5. If there is a sewer line within three hundred (300) feet of the property line, the Applicant shall connect to the District's sanitary sewer system.
6. The Applicant agrees that the provisions of sanitary sewer service touches and concerns the property and the terms of this Agreement bind the District and Applicant and their heirs, executors, administrators, personal representatives, successors, agents, attorneys, assigns, designees, and transferees.
- Called Jeff
4/1/14 @ 12:25pm*

The parties hereto have read and fully understand the above provisions and agree to comply with said provisions.

Signature _____

APPLICANT

Signature

[illegible]

SUBSCRIBED and sworn to before me this 24 day of March, 2014

My Commission Expires:

Signature _____



A Resident of

Hamilton County, Indiana

Rebecca Lynn Hunter, Notary Public

Printed

Notary Public

Resident of Hamilton County

Inspector _____ Date Inspected 4-1-14 Approved ✓ Rejected _____

Reason for Rejection

Date Reinspected	Approved	Rejected
------------------	----------	----------

Notes:

Size Pipe 6" Type Pipe MC 35

Basement Yes ☐ No ☒

Sump Pump Yes No

Downspout to Ground Yes ☒ No ☐


Septic Tank Pumped & Filled Yes No

Contractor **KOLTON**

Special Conditions

Existing Home

New Construction

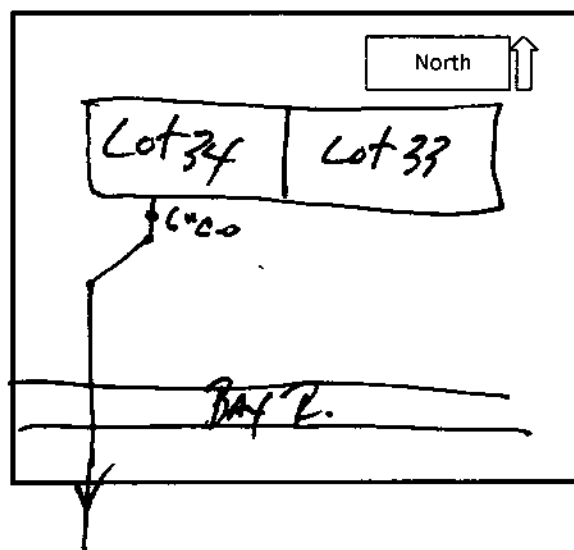

Don Moore turned permit in

Original check is printed on chemical reactive paper with fluorescent fiber content and a watermark - hold up to a light to view



MUSTIN BUILDERS, INC.
810 CENTRAL AVENUE
ANDERSON, IN 46012
PH. 765-644-8502


STAR
Financial Bank
PO Box 11409 • Fort Wayne, IN 46858-1409
71-167/749

302598

Six Thousand Seven Hundred Forty

DATE

3-26-14

CHECK NO.


302598

AMOUNT \$

6,740.00

PAY
TO THE
ORDER
OF

FCRW

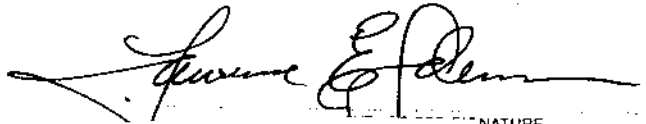

⑈302598⑈ ⑆074901672⑆

NATURE

MP

COPY