

add order  
or file



# FALL CREEK REGIONAL WASTE DISTRICT

9378 S. 650 West PO Box 59  
Pendleton, IN 46064-0059 778-7544

22-27660.00

Have Sego Builders

## APPLICATION FOR SEWER PERMIT

Nº 2740

Date 3/28/00

Permit Void 90 days from Date of Issuance

Owner Name Dave McFarland

Property Address 1726 W Raccoon Way

Lot # 99, HHE P.O. Box \_\_\_\_\_

Town Pendleton, IN Zip Code 46064

Phone \_\_\_\_\_ City Water \_\_\_\_\_ Well ☒

\$ \$400.00 Tap on Fee Paid

\$ N/A Inspection fee paid

Application is hereby made for connection to the Fall Creek Regional Waste District Sewer System for the above listed property - Permit Type: Residential ☒, Commercial \_\_\_\_\_, Industrial \_\_\_\_\_, or Governmental/Institutional \_\_\_\_\_. User Information \_\_\_\_\_.

All workmanship and materials shall conform to the standards of the District Ordinance as described in Ordinance 84-2 and 84-3 as amended. Acceptance and approval must be made by the District inspector or his duly authorized representative before backfilling and final connection is made to the main sewer lines. Any violation of applicable regulations will cause all lines and appurtenances in violation to be removed and replaced at the owners expense.

The Fall Creek Regional Waste District is responsible for the inspection, approval of materials, and installation techniques only. All costs for materials and installation and any liabilities resulting from same is the sole responsibility of the property owner.

I have read and fully understand the above provisions and agree to comply by said provisions.

James J. Swanson  
APPLICANT(S) SIGNATURE

INSPECTOR Tim

Date inspected 3-28-2000 Approved ☒ Rejected \_\_\_\_\_

Reason for rejection \_\_\_\_\_

Date reinspected \_\_\_\_\_ Approved \_\_\_\_\_ Rejected \_\_\_\_\_

Notes:

Size Pipe 6"

Type Pipe SDR 35

Basement Yes \_\_\_\_\_ No ☒

Sump Pump Yes \_\_\_\_\_ No ☒

Downspout to Ground Yes \_\_\_\_\_ No \_\_\_\_\_


Septic Tank Pumped & filled Yes \_\_\_\_\_ No \_\_\_\_\_

Contractor DAVID SEGGER EXCAVATING

Special Conditions \_\_\_\_\_

Existing Home \_\_\_\_\_

New Construction ☒

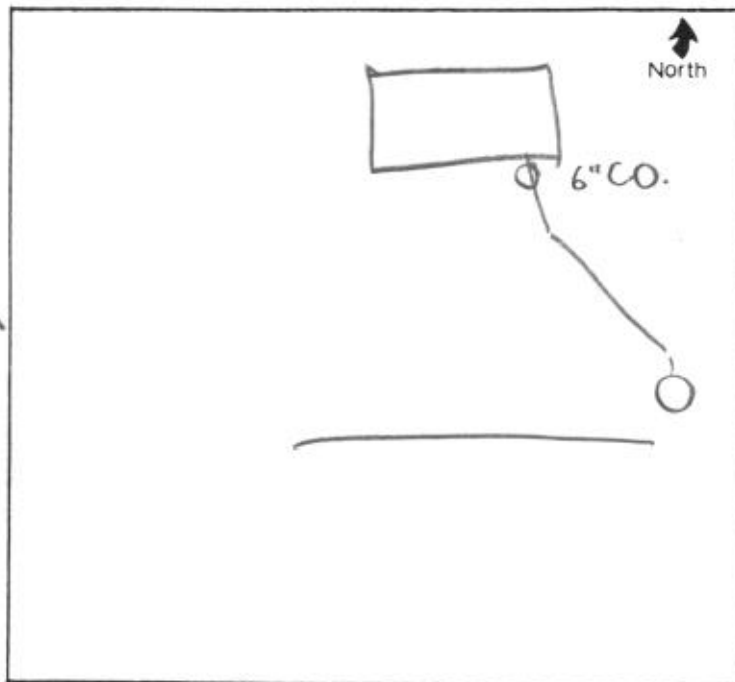

Handwritten notes at top left corner.

WEST GREEN SECTION 44 DISTRICT

22-2700-00



Handwritten text at the top right.

0153-2

22-2700-00

Handwritten text in the middle section, possibly a title or description.

Table with multiple columns and rows of data.

DATE	DESCRIPTION	AMOUNT
1-1-1900	...	...
2-1-1900	...	...
3-1-1900	...	...
31-1-1900	...	...

Handwritten text at the bottom of the page.

13601

**DAVE SEGO BUILDERS, INC.**

3077 WEST US 40  
GREENFIELD, IN 46140-9217  
(317) 462-8806

FIFTH THIRD BANK  
OF CENTRAL INDIANA  
INDIANAPOLIS, INDIANA  
71-859-749

3/28/2000

PAY TO THE  
ORDER OF

FALL CREEK REGIONAL WASTE DISTRICT


\$ \*\*400.00

Four Hundred and 00/100\*\*\*\*\*

DOLLARS

FALL CREEK REGIONAL WASTE DISTRICT

MEMO

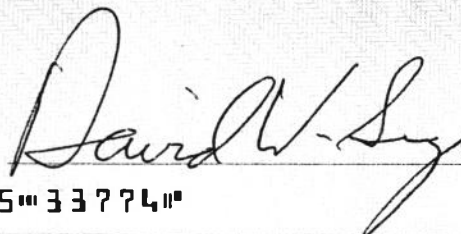

MP

⑈013601⑈ ⑆074908594⑆

745⑈33774⑈