



# FALL CREEK REGIONAL WASTE DISTRICT

9378 S. 650 West PO Box 59  
Pendleton, IN 46064-0059 778-7544 22-27665.00

*add order  
on file*

*Stailey Enterprises*

No 2697

## APPLICATION FOR SEWER PERMIT

Date 8-10-99

Permit Void 90 days from Date of Issuance

Owner Name TERRY & DEBRA STAILEY

Property Address 1735 RACCOON WAY PENDLETON IN.

Lot # 96, HHE P.O. Box \_\_\_\_\_

Town PENDLETON, IN Zip Code 46064

Phone \_\_\_\_\_ City Water \_\_\_\_\_ Well ☒

\$ 400<sup>00</sup> Tap on Fee Paid

\$ \_\_\_\_\_ ~~Inspection fee paid~~

Application is hereby made for connection to the Fall Creek Regional Waste District Sewer System for the above listed property - Permit Type: Residential ☒, Commercial \_\_\_\_\_, Industrial \_\_\_\_\_, or Governmental/Institutional \_\_\_\_\_. User Information \_\_\_\_\_.

All workmanship and materials shall conform to the standards of the District Ordinance as described in Ordinance 84-2 and 84-3 as amended. Acceptance and approval must be made by the District inspector or his duly authorized representative before backfilling and final connection is made to the main sewer lines. Any violation of applicable regulations will cause all lines and appurtenances in violation to be removed and replaced at the owners expense.

The Fall Creek Regional Waste District is responsible for the inspection, approval of materials, and installation techniques only. All costs for materials and installation and any liabilities resulting from same is the sole responsibility of the property owner.

I have read and fully understand the above provisions and agree to comply by said provisions.

*Terry Stailey*  
APPLICANT(S) SIGNATURE

\*\*\*\*\*  
INSPECTOR TIM

Date inspected 10-1-99 Approved ☒ Rejected \_\_\_\_\_

Reason for rejection \_\_\_\_\_

Date reinspected \_\_\_\_\_ Approved \_\_\_\_\_ Rejected \_\_\_\_\_

### Notes:

Size Pipe 6"

Type Pipe SDR 35

Basement Yes \_\_\_\_\_ No ☒

Sump Pump Yes \_\_\_\_\_ No \_\_\_\_\_

Downspout to Ground Yes \_\_\_\_\_ No \_\_\_\_\_


Septic Tank Pumped & filled Yes \_\_\_\_\_ No \_\_\_\_\_

Contractor LONG EXC.

Special Conditions \_\_\_\_\_

Existing Home \_\_\_\_\_

New Construction ☒

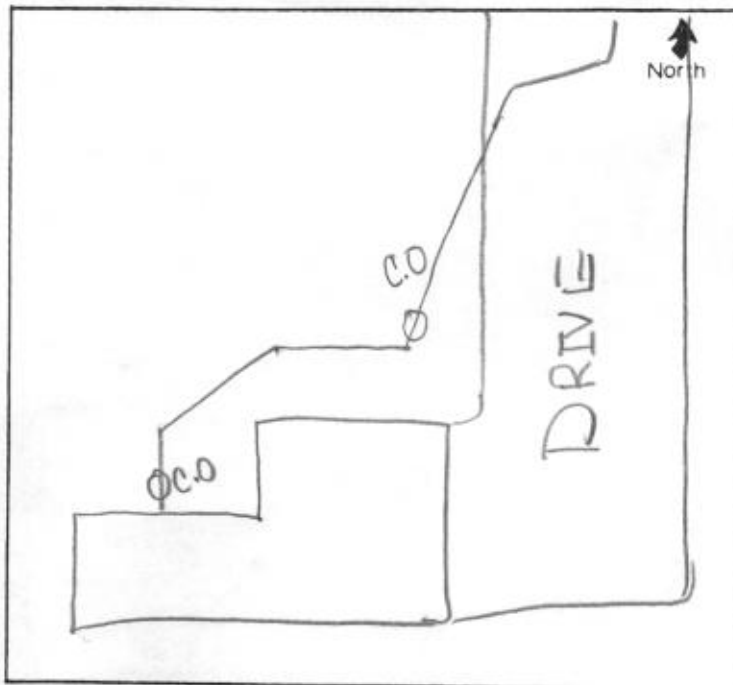



STAILEY ENTERPRISES INC.

PH 765-747-5199

P.O. BOX 447

YORKTOWN, IN 47396-0447

71-65/749

1648

PAY TO THE  
ORDER OF

Fall Creek Regional

\$400.00

Four Hundred Dollars and 00/100

DOLLARS

Security features  
included.  
Details on back.



First Merchants Bank

First Merchants Bank, N.A. Muncie, Indiana

SEWER TRIP FEE

FOR

Lot 96 Hickory Hills

Terry Stanley

MP

⑆074900657⑆ 177 289 9⑈

1648

CHAPMAN