


1745 E 67th ST

new grease trap installed

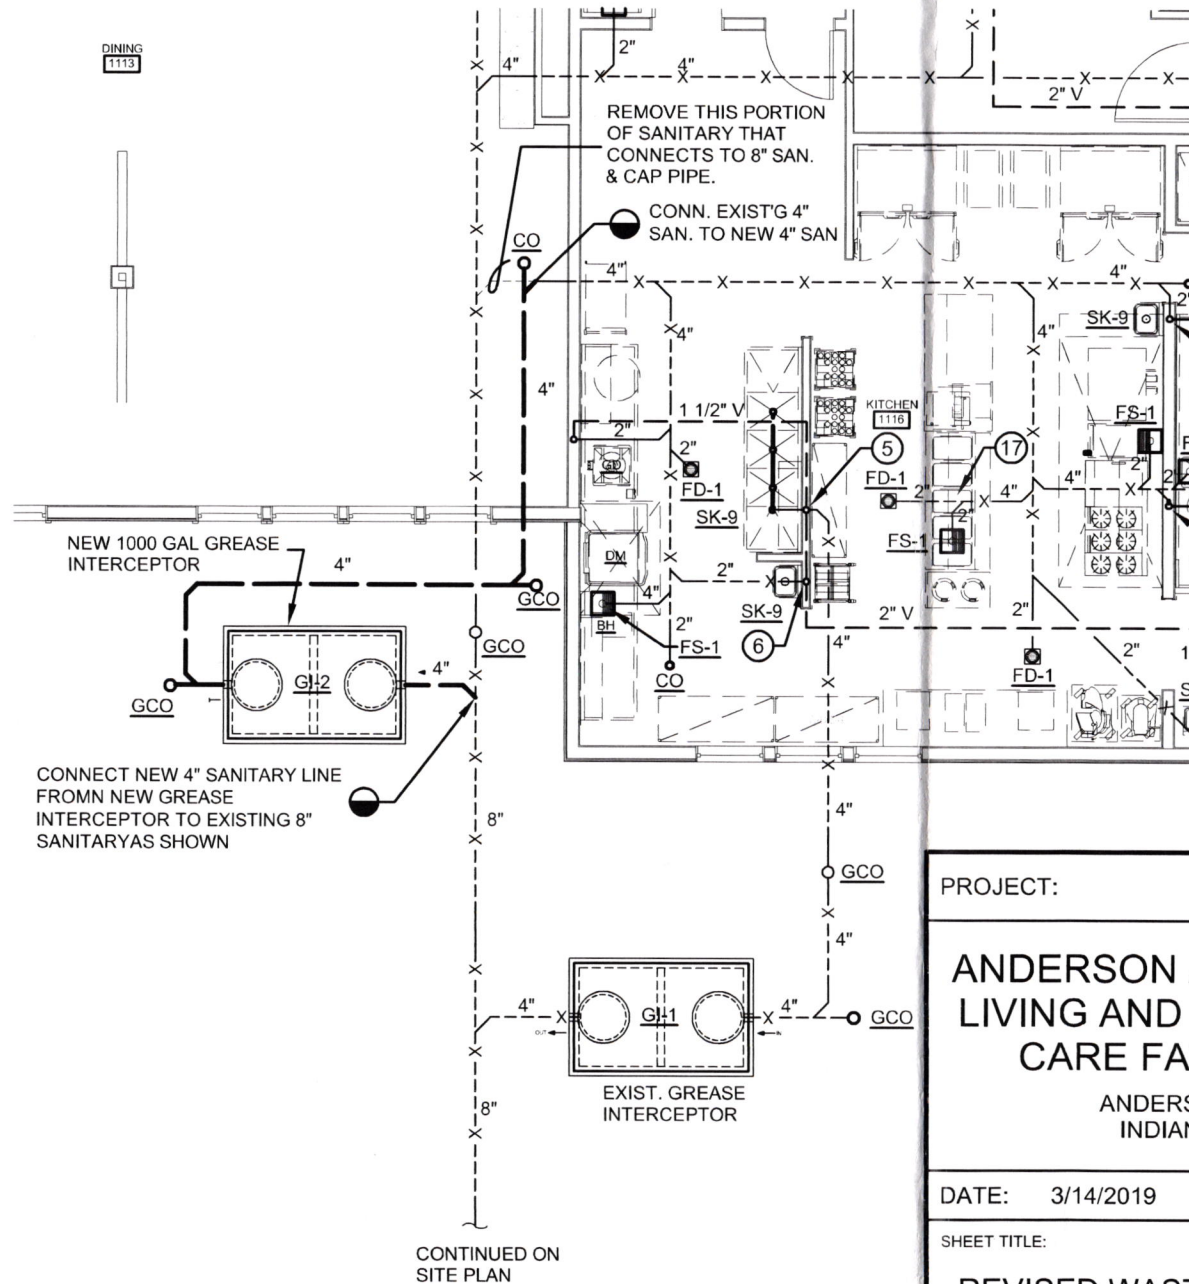

MECHANICAL SPECIFICATIONS

1. ALL MECHANICAL WORK SHALL CONFORM TO THE LATEST EDITION OF THE INTERNATIONAL PLUMBING AND MECHANICAL CODES AS ADOPTED BY THE STATE OF INDIANA AND ALL LOCAL CODES AS THEY MAY APPLY.
2. DO ALL EXCAVATION AND BACKFILL AS REQUIRED IN ACCORDANCE WITH THE GENERAL CONDITIONS.
3. SANITARY SEWER SHALL BE PIPED FROM THE EXISTING KITCHEN SANITARY TO THE EXISTING INLET LINE TO THE GREASE INTERCEPTOR.
4. PIPE AND FITTINGS: PVC SCHEDULE 40, ASTM D2665, SOLVENT CEMENT ASTM D2564.
5. FURNISH AND INSTALL ALL SANITARY CLEANOUTS AS INDICATED.
6. FIELD VERIFY EXISTING INVERTS AT CONNECTION AND TIE-IN POINTS PRIOR TO INSTALLATION.
7. DO ALL CUTTING AND PATCHING INVOLVED IN THE INSTALLATION OF THIS WORK.
8. REMOVE ALL DEBRIS AND SURPLUS MATERIAL FROM THE PREMISES AS PROGRESS OF THE WORK DICTATES.
9. AT COMPLETION OF PROJECT, PROVIDE WARRANTIES, AND RED LINE AS-BUILT DRAWINGS.

PROJECT:

ANDERSON ASSISTED
LIVING AND MEMORY
CARE FACILITY

ANDERSON,
INDIANA

DATE: 3/14/2019

SHEET TITLE:

REVISED WASTE PIPING
PLAN - KITCHEN AREA

CERTIFICATION



Lon B Leech