C R W
CLEAN
TOMORROW
TODAY!

## FALL CREEK REGIONAL WASTE DISTRICT

Box 44, Pendleton, Indiana 46064

22-28380.00

add order

Permit No. Date 12-29-93

Permit Void 90 days from Date of Issuance
Owner Name DARLY W. Gustin

Property Address 1777 W RACCOON WAY

Lot # 34 P.O. Box

Town PENDIFTON , IN zip Code 41.064

Phone Water Meter "

\$ 35000 Tap on Fee Paid Availability fee 1.043.50 3/4/94

Application is hereby made for connection to the Fall Creek Regional Waste District Sewer System for the above listed property - Permit Type:
Residential 7, Commercial , Industrial , or Governmental/
Institutional . User Information

All workmanship and materials shall conform to the standards of the District Ordinance as described in Ordinance 84-2 and 84-3 as amended.

The Fall Creek Regional Waste District is responsible for the inspection, approval of materials, and installation techniques only. All costs for materials and installation and any liabilities resulting from same is the sole responsibility of the property owner.

Acceptance and approval must be made by the District inspector or his duly authorized representative before backfilling and final connection is made to the main sewer lines. Any violation of applicable regulations will cause all lines and appurtenances in violation to be removed and replaced

Notes:
Size Pipe

Type Pipe

Basement Yes

No

Sump Pump Yes

No

Downspout to Ground Yes No

Septic Tank Pumped & filled Yes


Contractor

Dick Godbey

Special Conditions

at the owners expense.

Existing Home

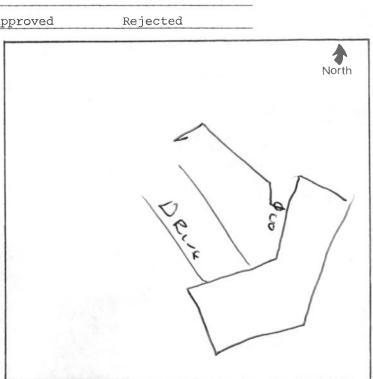

W A CHANGE

## PAUL CREEK REGIONAL WASTE DISTRICT

los AA, Pendikton; Indiano Accon

22-28380.00

186100 JM	
	manufactured by a patricipal to the second
	7 25 81 7
	706
	X - Participal
	Xiii Yan Yan Yan
	and I was brought to the quarter
	You and letter actions over legal
15	
\" / 37/	
	Exist About