

Fall Creek Regional Waste District
9378 S 650 W, P.O. Box 59, Pendleton, IN 46064
765-778-7544

#6770

Agreement for Sanitary Sewer Service

This Agreement made and entered into this 21 day of October, 2018 between Fall Creek Regional Waste District ("District") and Travis Gray ("Applicant") regarding the provision of sanitary sewer service, and the assignment of capacity in and connection to, the District's facilities for the premises located at _____.

Street Address: 1780 W Huntsville RD, Pendleton

Now therefore, the parties, in consideration of the mutual promises set out in this Agreement, the receipt and sufficiency of which is hereby acknowledged, agree as follows:

1. The Applicant agrees that all workmanship and materials shall conform to all District ordinances and the District's construction standards. District must accept and approve all work and materials before backfilling and final connection is made to the sewer mains. Any violation of this provision will cause all lines and appurtenances in violation to be removed and replaced at the Applicant's expense.
2. The District shall have the right to enter upon the Applicant's premises at all reasonable times to inspect, repair, or replace any equipment used in connection with the District's service or which has an impact on said service.
3. The Applicant shall be responsible for all monthly user rates, capacity charges, and tap fees. The failure to pay any rate charge or fee may result in a lien against the property and/or the termination of service to the property, the cost of which will be borne by Applicant, including, but not limited to, all attorney's fees and collection costs.
4. The District shall not be responsible for any damages as a result of any failure to supply service unless said damages are due to default, neglect or culpability on the part of the District.
5. If there is an available sanitary sewer within three hundred (300) feet of the property line, the property owner shall be required to connect to the District's sanitary sewer system.
6. The Applicant and District agree that the provision of sanitary sewer service touches and concerns the property and the terms of this Agreement bind the District and Applicant and their heirs, executors, administrators, personal representatives, successors, agents, attorneys, assigns, designees, and transferees.

The parties hereto have read and fully understand the above provisions and agree to comply with said provisions.

FALL CREEK REGIONAL WASTE DISTRICT

APPLICANT

Signature _____

Signature _____

STATE OF INDIANA)
) SS:
COUNTY OF MADISON)

SUBSCRIBED and sworn to before me this ____ day of _____, 20__

My Commission Expires: _____

Signature _____

Printed _____

Notary Public

Resident of _____ County

Inspector Don Date Inspected 10-3-18 Approved ☒ Rejected _____

Reason for Rejection _____
Date Reinspected _____ Approved _____ Rejected _____

Notes:

Size Pipe 6" Type Pipe PVC 35

Basement Yes ☒ No _____

Sump Pump Yes ☒ No _____

Downspout to Ground Yes ☒ No _____

Septic Tank Pumped & Filled Yes ☒ No NA

Contractor WATSON EX.

Special Conditions _____

Existing Home _____

New Construction ☒

North ↑

3 pictures attached

Previous connection
old house torn down existing tap
new house built using old tap


10-3-18

1780 W. Harts Rd
Hickory Hills East

DR. Watson EX.

N
↓

RECONNECTED to
EXISTING WATER

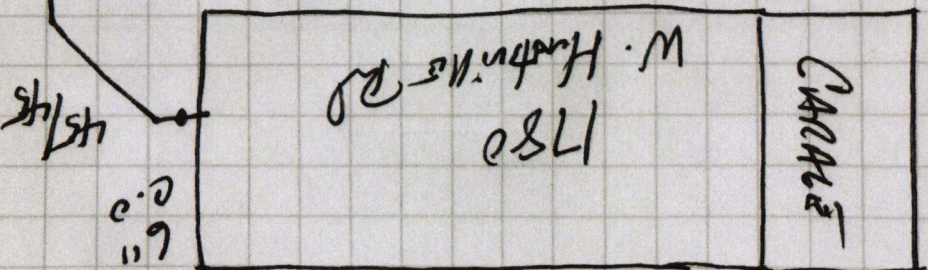

Woodchuck

Harts Rd

PRICES

TION

ICES
ATIONS
SERVICES
INDERS

3 REPAIR
ENT
MENT

POXY
ING

IG
NT REPAIRS

ANCY
SERVICE
AINED

1-8509
1-8060

ARK DRIVE

47394

acting.com

780 W Huntsville

Don Moore 10.3.18



1780 W Huntsville RD

Don Moore

10.3.18





FALL CREEK REGIONAL WASTE DISTRICT

9378 S. 650 West PO Box 59
Pendleton, IN 46064-0059 778-7544

add order
on file

22-27210.00

APPLICATION FOR SEWER PERMIT

Nº 2037

Date

4-21-94

Permit Void 90 days from Date of Issuance

Owner Name

Greg Mundell

Property Address

1780 W. Huntsville Rd.

Lot #

5

P.O. Box

Town

Pendleton

, IN

Zip Code

46064

Phone

778-4820

City Water

Well

X

\$

700.⁰⁰

Tap on Fee Paid

\$

25.⁰⁰

Inspection fee paid

Application is hereby made for connection to the Fall Creek Regional Waste District Sewer System for the above listed property - Permit Type: Residential ☐, Commercial ☐, Industrial ☐, or Governmental/Institutional ☐. User Information

All workmanship and materials shall conform to the standards of the District Ordinance as described in Ordinance 84-2 and 84-3 as amended. Acceptance and approval must be made by the District inspector or his duly authorized representative before backfilling and final connection is made to the main sewer lines. Any violation of applicable regulations will cause all lines and appurtenances in violation to be removed and replaced at the owners expense.

The Fall Creek Regional Waste District is responsible for the inspection, approval of materials, and installation techniques only. All costs for materials and installation and any liabilities resulting from same is the sole responsibility of the property owner.

I have read and fully understand the above provisions and agree to comply by said provisions.

Greg Mundell

APPLICANT(S) SIGNATURE

INSPECTOR

Tim

Date inspected

5-21-94

Approved

☒

Rejected

Reason for rejection

Date reinspected

Approved

Rejected

Notes:

Size Pipe

6"

Type Pipe

SOR 35

Basement Yes

No ☒

Sump Pump Yes

No ☒

Downspout to Ground Yes

No ☒

Septic Tank Pumped & filled Yes

No ☒

Contractor


McKenny Const.

Special Conditions

Existing Home

☒

New Construction

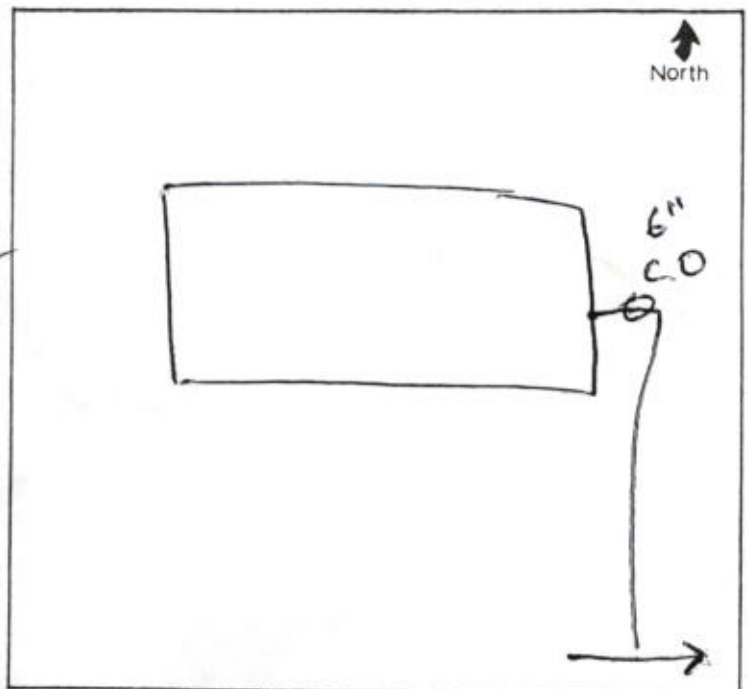

Handwritten notes at top left.

Handwritten text at top center.

Handwritten notes at top right.

Handwritten text below top center.

Handwritten text below top center.

Large block of faint handwritten text.

Large block of faint handwritten text.

Handwritten text in the middle of the page.

Small handwritten mark.

Handwritten text in the middle of the page.

Handwritten text in the middle of the page.

Handwritten text in the middle of the page.

