



FALL CREEK REGIONAL WASTE DISTRICT

9378 S. 650 West PO Box 59
Pendleton, IN 46064-0059 778-7544

add order
on file

22-27056.00

Nº 2197

APPLICATION FOR SEWER PERMIT

Date

5/10/95

Permit Void 90 days from Date of Issuance

Owner Name

Mustin Builders, Inc.

Jeff & Joni Burnett

Property Address

1788

W.

Raccoon Way

Lot #

37, Hickory Hills East

P.O. Box

Town

Pendleton

IN

Zip Code

Phone

City Water

Well

✓

\$

700.00

Tap on Fee Paid

\$

25.00

Inspection fee paid

Application is hereby made for connection to the Fall Creek Regional Waste District Sewer System for the above listed property - Permit Type: Residential ☒, Commercial ☐, Industrial ☐, or Governmental/Institutional ☐. User Information

All workmanship and materials shall conform to the standards of the District Ordinance as described in Ordinance 84-2 and 84-3 as amended. Acceptance and approval must be made by the District inspector or his duly authorized representative before backfilling and final connection is made to the main sewer lines. Any violation of applicable regulations will cause all lines and appurtenances in violation to be removed and replaced at the owners expense.

The Fall Creek Regional Waste District is responsible for the inspection, approval of materials, and installation techniques only. All costs for materials and installation and any liabilities resulting from same is the sole responsibility of the property owner.

I have read and fully understand the above provisions and agree to comply by said provisions.

APPLICANT(S) SIGNATURE

INSPECTOR

Don

Date inspected

6/23/95

Approved

✓

Rejected

Reason for rejection

Date reinspected

Approved

Rejected

Notes:

Size Pipe

6"

Type Pipe

PVC

Basement Yes

No

Sump Pump Yes

No

Downspout to Ground Yes

No

Septic Tank Pumped & filled Yes

No

Contractor


Bolton

Special Conditions

Existing Home

New Construction

✓

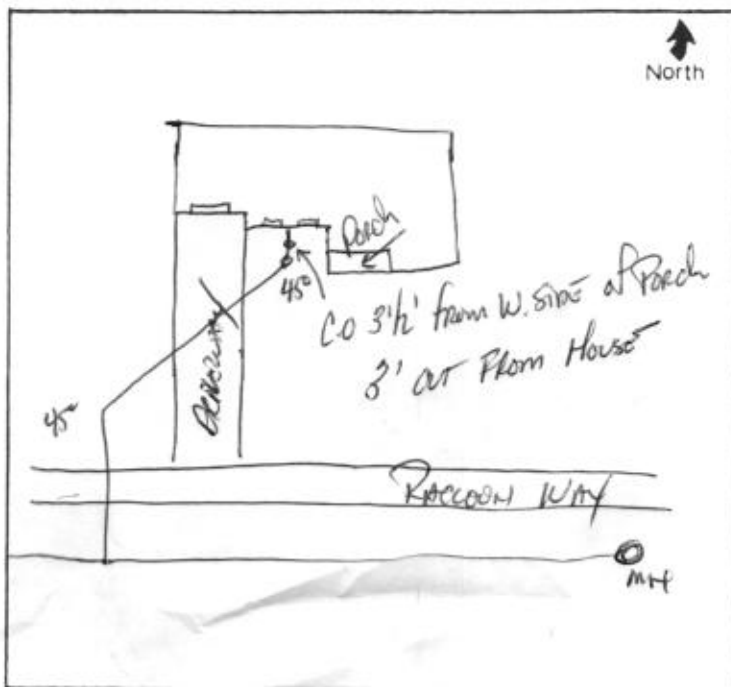

MUSTIN BUILDERS, INC.

DATE	INVOICE NO.	DESCRIPTION	INVOICE AMOUNT	DEDUCTION	BALANCE
5-09-95	50995	Lot 37 Hickory Hills East sewer tap			
CHECK DATE	5-9-95	CHECK NUMBER	16067	TOTALS	\$725.00
					\$725.00

PLEASE DETACH THIS PORTION AND RETAIN FOR YOUR RECORDS

**MUSTIN BUILDERS, INC.**810 CENTRAL AVENUE
ANDERSON, IN 46012
PH. 317-644-8502**CITIZENS BANKING CO.**
ANDERSON, IN 46015
71-70-749**16067**

PAY: Seven Hundred Twenty-Five and no/100 Dollars

DATE	CHECK NO.	AMOUNT
5-9-95	16067	\$725.00

PAY
TO THE
ORDER
OFFall Creek Waste Management
P. O. Box 59
County Road 650 West
Pendleton, IN 46064

J#1239-108

⑈016067⑈ ⑆074900709⑆ 0105219101⑈