



# FALL CREEK REGIONAL WASTE DISTRICT

9378 S. 650 West PO Box 59  
Pendleton, IN 46064-0059 778-7544

8-17136.01

## APPLICATION FOR SEWER PERMIT

Nº 2254

Date 8/30/95

Permit Void 90 days from Date of Issuance

Owner Name Ellen K. Shaw Dick Butler

Property Address 178 ~~177~~ W Fall Creek Parkway

Lot # \_\_\_\_\_ P.O. Box \_\_\_\_\_

Town Pendleton, IN Zip Code 46064

Phone \_\_\_\_\_ City Water ☒ Well \_\_\_\_\_

\$ 700.00 Tap on Fee Paid

\$ \_\_\_\_\_ Inspection fee paid

Application is hereby made for connection to the Fall Creek Regional Waste District Sewer System for the above listed property - Permit Type: Residential ☒, Commercial \_\_\_\_\_, Industrial \_\_\_\_\_, or Governmental/Institutional \_\_\_\_\_. User Information \_\_\_\_\_.

All workmanship and materials shall conform to the standards of the District Ordinance as described in Ordinance 84-2 and 84-3 as amended. Acceptance and approval must be made by the District inspector or his duly authorized representative before backfilling and final connection is made to the main sewer lines. Any violation of applicable regulations will cause all lines and appurtenances in violation to be removed and replaced at the owners expense.

The Fall Creek Regional Waste District is responsible for the inspection, approval of materials, and installation techniques only. All costs for materials and installation and any liabilities resulting from same is the sole responsibility of the property owner.

I have read and fully understand the above provisions and agree to comply by said provisions.

Ellen K. Shaw by Joseph E. Cinnarak her father  
APPLICANT(S) SIGNATURE

\*\*\*\*\*

INSPECTOR B

Date inspected 8-21-01 Approved ☒ Rejected \_\_\_\_\_

Reason for rejection \_\_\_\_\_

Date reinspected \_\_\_\_\_ Approved \_\_\_\_\_ Rejected \_\_\_\_\_

Notes:

Size Pipe 4" 1.5"

Type Pipe PVC

Basement Yes ☒ No \_\_\_\_\_

Sump Pump Yes \_\_\_\_\_ No ☒

Downspout to Ground Yes ☒ No hydrant


Septic Tank Pumped & filled Yes ☒ No \_\_\_\_\_

Contractor MARK SMITH

Special Conditions \_\_\_\_\_

Existing Home ☒

New Construction \_\_\_\_\_

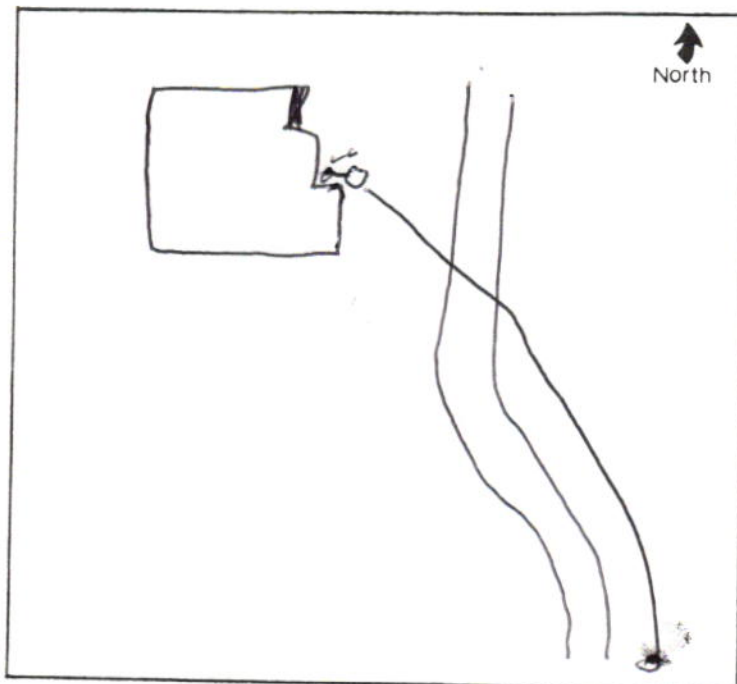

JAMES R. BUTLER  
SANDI N. BUTLER  
178 FALL CREEK PKY  
PENDLETON, IN 46064  
PH: (765) 778-4534

1920

8-20-01 DATE

71-7280/2749  
BRANCH 1

PAY TO THE  
ORDER OF

Fall Creek Waste

\$ 1024.00

One Thousand Twenty Four

00/100 DOLLARS

Security  
Features  
Details on  
Back

Madison  
County  
Federal Credit Union

(765) 644-3623

Anderson, Indiana 46015

FOR

Shinder Pump

James R. Butler

⑆274972605⑆

1920