

add order  
on file



# FALL CREEK REGIONAL WASTE DISTRICT

9378 S. 650 West PO Box 59  
Pendleton, IN 46064-0059 778-7544

13-50629-99

## APPLICATION FOR SEWER PERMIT

No 2141

Date

9/30/94

Permit Void 90 days from Date of Issuance

Owner Name Crossmann Communities, Inc.

Property Address 150 Oxford Avenue

Lot # 19

P.O. Box

Town Pendleton

IN Zip Code 46064

Phone

City Water

Well

\$ 700.00

Tap on Fee Paid

\$ 25.00

Inspection fee paid

Application is hereby made for connection to the Fall Creek Regional Waste District Sewer System for the above listed property - Permit Type: Residential ☒, Commercial ☐, Industrial ☐, or Governmental/Institutional ☐. User Information

All workmanship and materials shall conform to the standards of the District Ordinance as described in Ordinance 84-2 and 84-3 as amended. Acceptance and approval must be made by the District inspector or his duly authorized representative before backfilling and final connection is made to the main sewer lines. Any violation of applicable regulations will cause all lines and appurtenances in violation to be removed and replaced at the owners expense.

The Fall Creek Regional Waste District is responsible for the inspection, approval of materials, and installation techniques only. All costs for materials and installation and any liabilities resulting from same is the sole responsibility of the property owner.

I have read and fully understand the above provisions and agree to comply by said provisions

APPLICANT(S) SIGNATURE

INSPECTOR

Date inspected

Approved

Rejected

Reason for rejection

Date reinspected

Approved

Rejected

Notes:

Size Pipe

6"

Type Pipe

PVC

Basement Yes

No

Sump Pump Yes

No

Downspout to Ground Yes

No

Septic Tank Pumped & filled Yes

No

Contractor


Haberman

Special Conditions

Existing Home

New Construction

MA

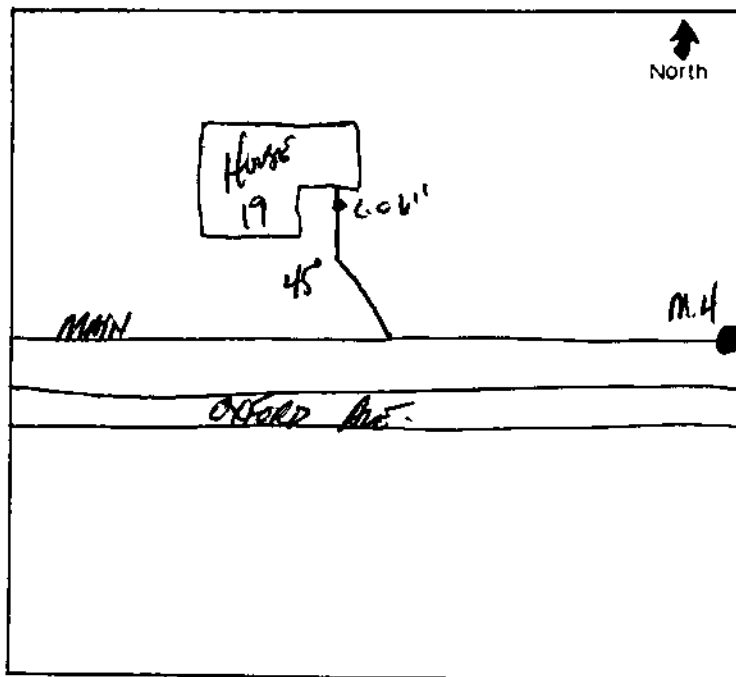




CONSULTING ENGINEERS  
LAND SURVEYORS  
9940 Allisonville Rd. • P.O. Box 509007 • Indianapolis, IN 46250  
(317) 849-5935 • 1-800-728-6917 • FAX: (317) 849-5942

JOB ID CF.19

CONTROL # 21318 TRI

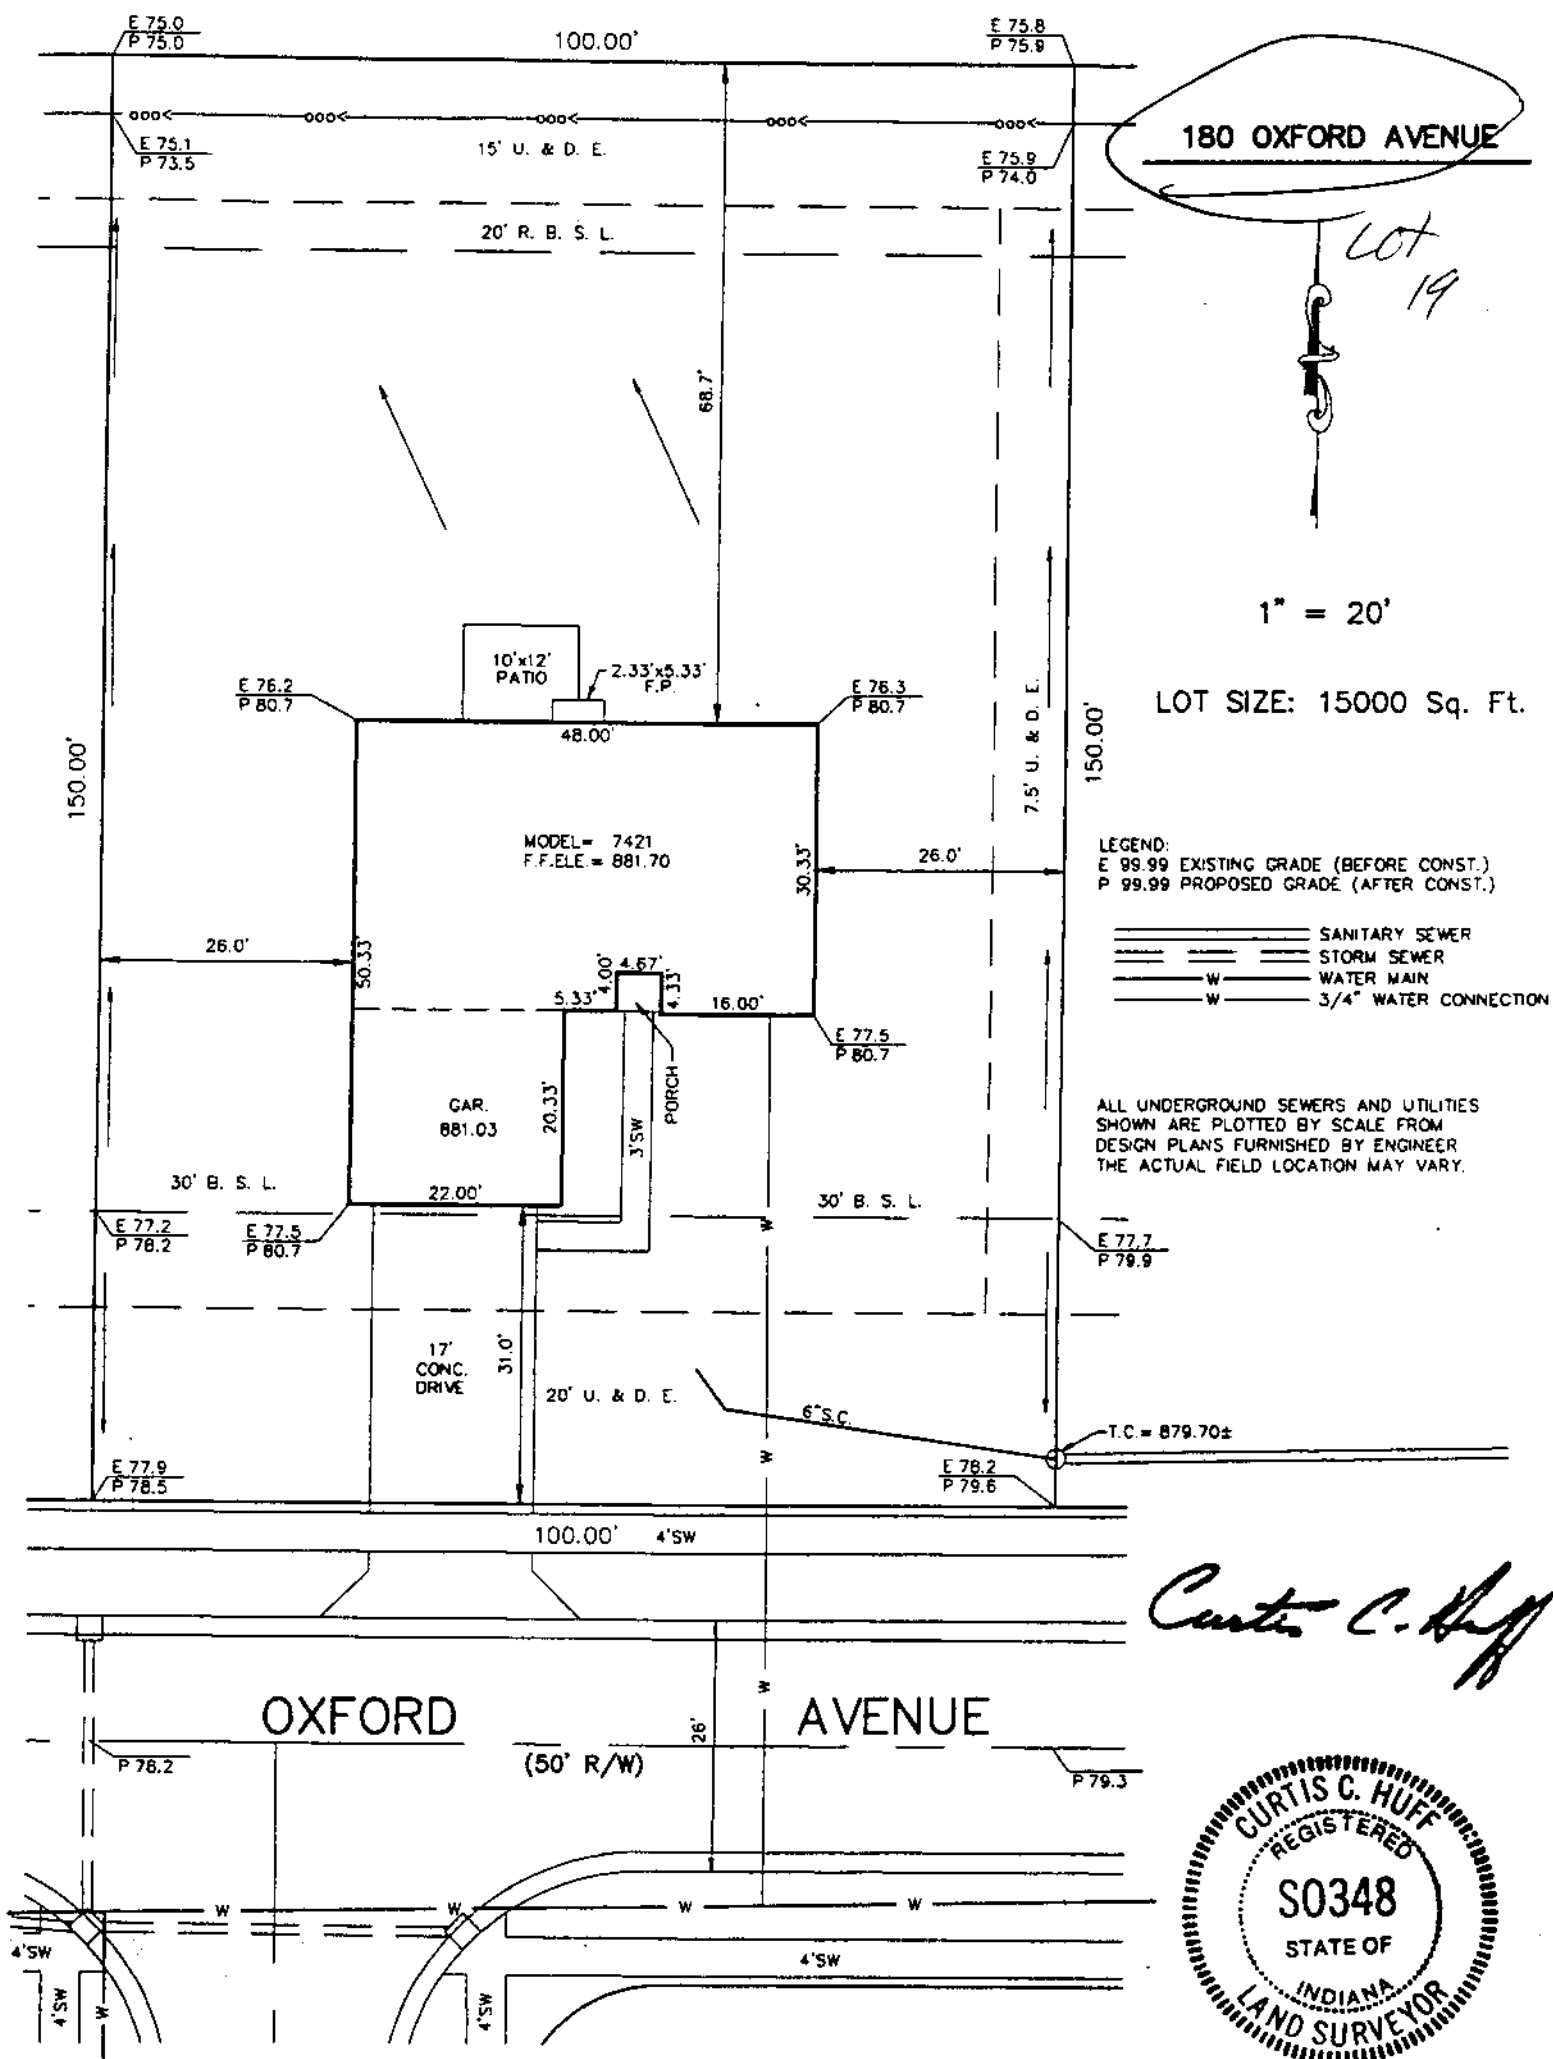

LOT 19 - COUNTRY FARMS

INST. No. 9402164  
BK. 20, PG. 123-125

8/23/94 LMC

"Don't Dig Blind"

Call Two working days before you dig.

It's the Law

1-800-382-5544