


3.30.17

Maplewood

Hartung Farms Lot

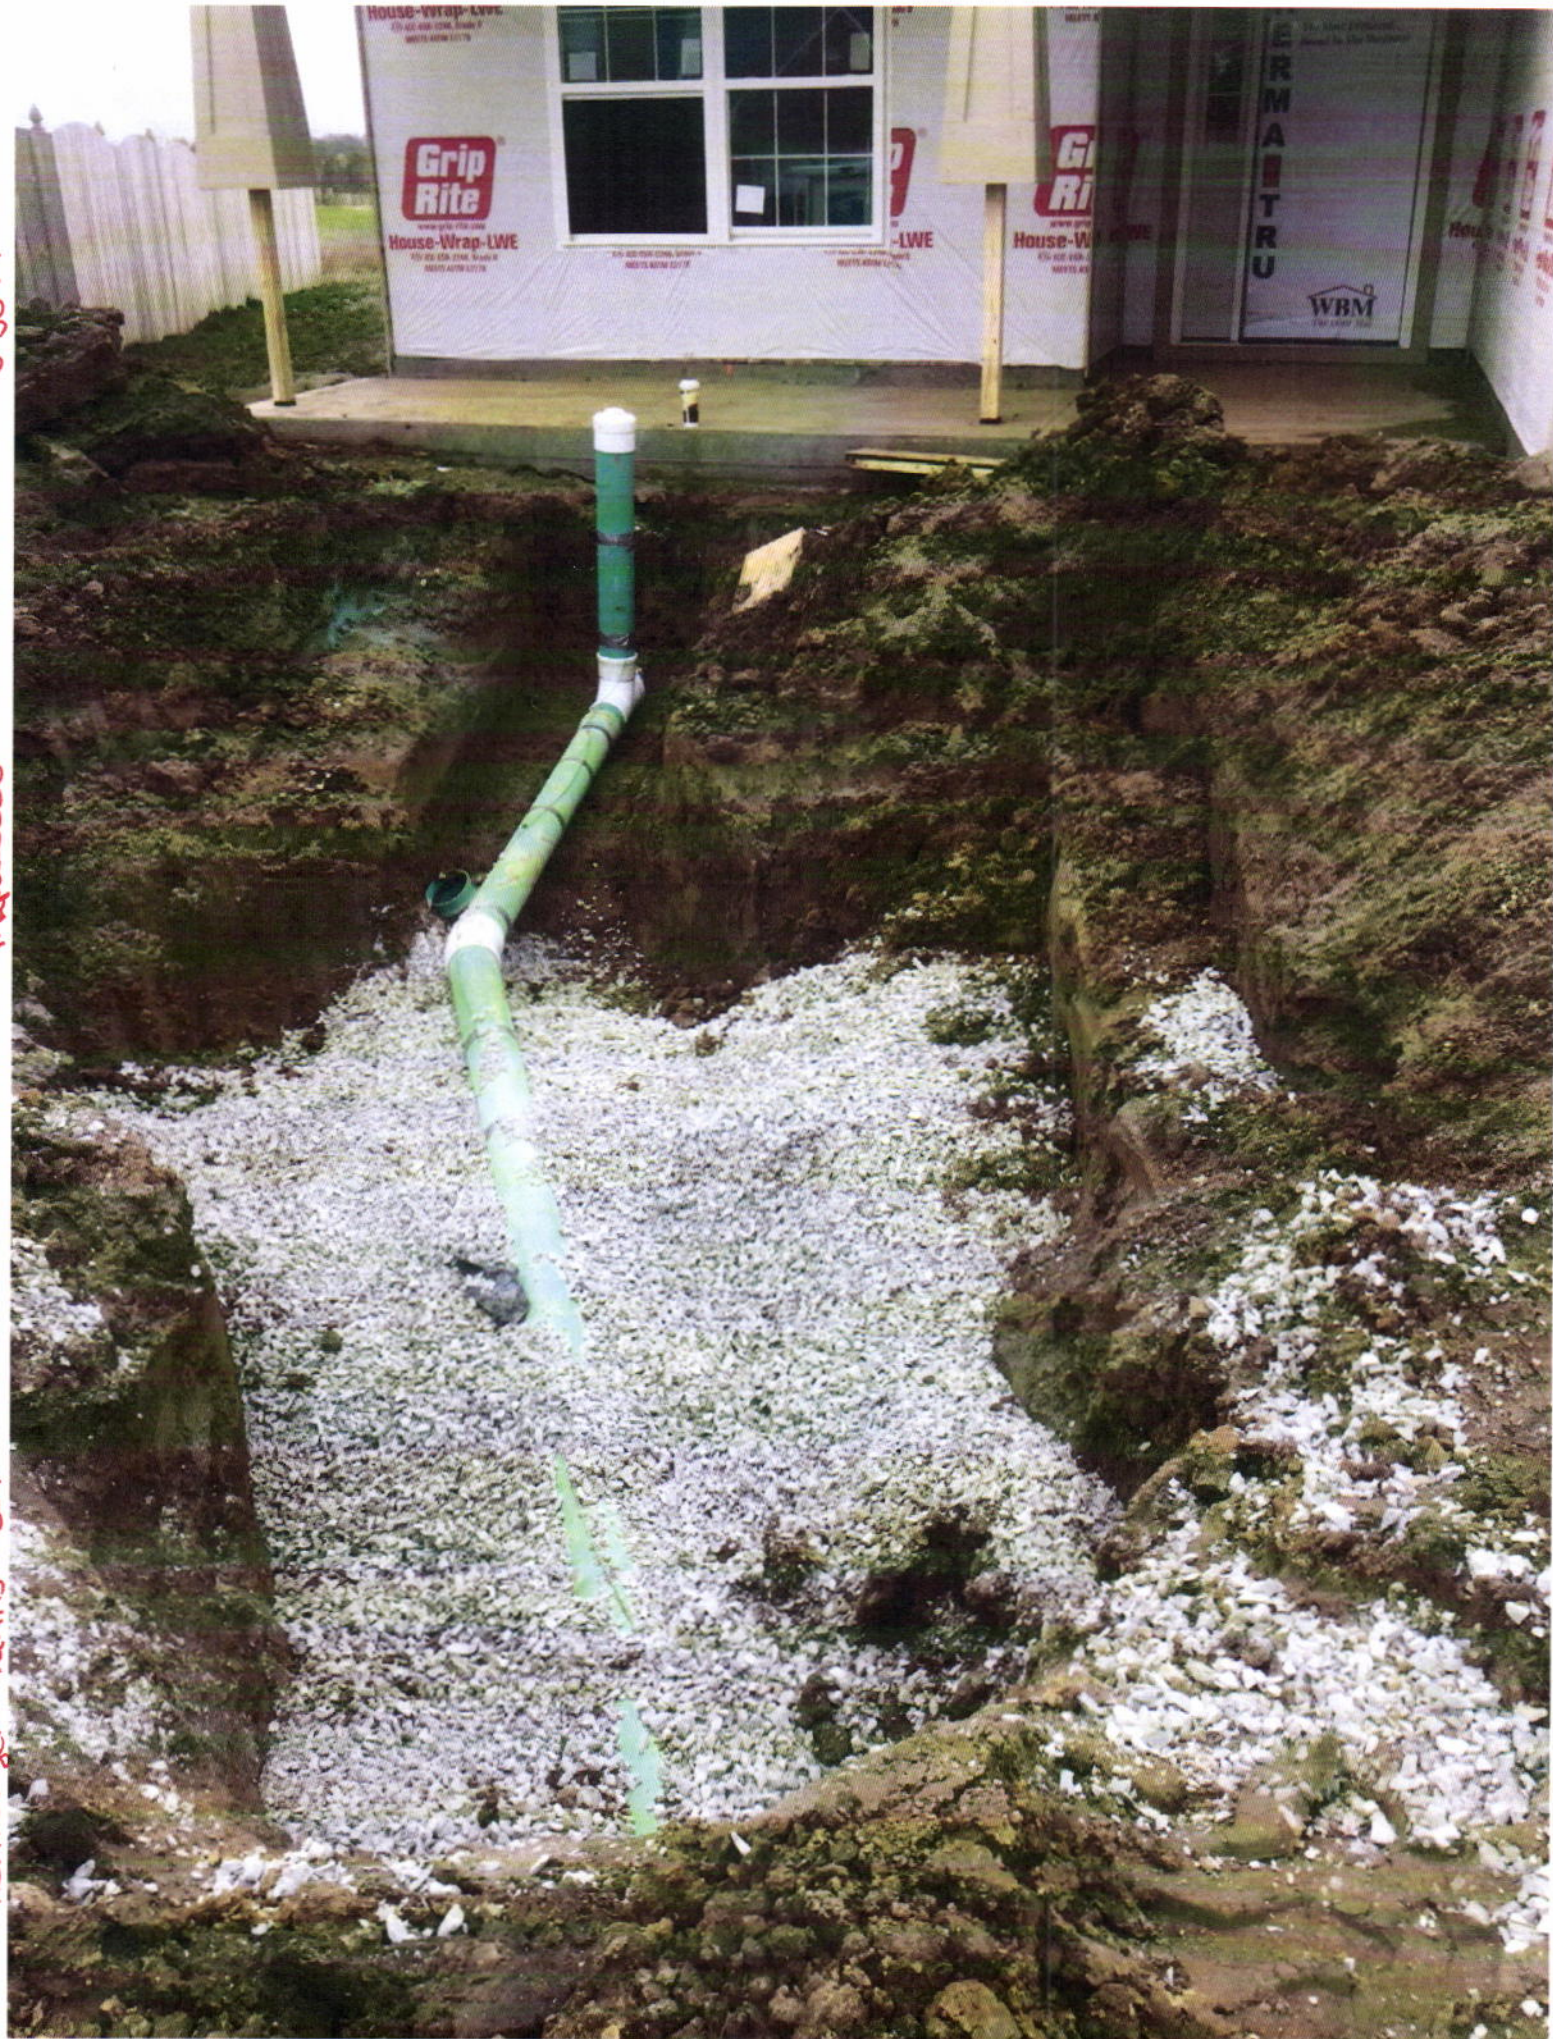

ARBOR HOMES, L.L.C.

PERMIT ACCOUNT

6626 E. 75TH STREET, SUITE 400
INDIANAPOLIS, IN 46250

71-65/749

First Merchants Bank

www.firstmerchants.com

029531

DATE 9/15/2016

PAY
TO THE
ORDER OF

Fall Creek Regional Waste District

\$ 3,370.00

Three Thousand Three Hundred And Seventy Dollars And 0/100

DOLLARS

FOR

HUNTZ 49

NOT VALID FOR AMOUNTS OVER \$10,000



BY:

AUTHORIZED SIGNATURE

Rec. # 010524