

22-27054.00

add order  
on file



# FALL CREEK REGIONAL WASTE DISTRICT

9378 S. 650 West PO Box 59  
Pendleton, IN 46064-0059 778-7544

## APPLICATION FOR SEWER PERMIT

Nº 2139

Date 9/26/94

Permit Void 90 days from Date of Issuance

Owner Name P. Eric Ayers

Property Address 1812 W. Raccoon Way

Lot # 39 P.O. Box \_\_\_\_\_

Town Pendleton, IN Zip Code 46064

Phone \_\_\_\_\_ City Water \_\_\_\_\_ Well ☒

\$ 700.00 Tap on Fee Paid

\$ 25.00 Inspection fee paid

Application is hereby made for connection to the Fall Creek Regional Waste District Sewer System for the above listed property - Permit Type: Residential ☒, Commercial \_\_\_\_\_, Industrial \_\_\_\_\_, or Governmental/Institutional \_\_\_\_\_. User Information \_\_\_\_\_.

All workmanship and materials shall conform to the standards of the District Ordinance as described in Ordinance 84-2 and 84-3 as amended. Acceptance and approval must be made by the District inspector or his duly authorized representative before backfilling and final connection is made to the main sewer lines. Any violation of applicable regulations will cause all lines and appurtenances in violation to be removed and replaced at the owners expense.

The Fall Creek Regional Waste District is responsible for the inspection, approval of materials, and installation techniques only. All costs for materials and installation and any liabilities resulting from same is the sole responsibility of the property owner.

I have read and fully understand the above provisions and agree to comply by said provisions.

P. Eric Ayers  
APPLICANT(S) SIGNATURE

\*\*\*\*\*

INSPECTOR Bm

Date inspected 9-29-94 Approved ☒ Rejected \_\_\_\_\_

Reason for rejection \_\_\_\_\_

Date reinspected \_\_\_\_\_ Approved \_\_\_\_\_ Rejected \_\_\_\_\_

Notes:

Size Pipe 6 "

Type Pipe PVC

Basement Yes ☒ No ☒

Sump Pump Yes ☒ No \_\_\_\_\_

Downspout to Ground Yes ☒ No ☒ Septic P.P.


Septic Tank Pumped & filled Yes ☒ No ☒

Contractor TRI County

Special Conditions \_\_\_\_\_

Existing Home \_\_\_\_\_

New Construction ☒

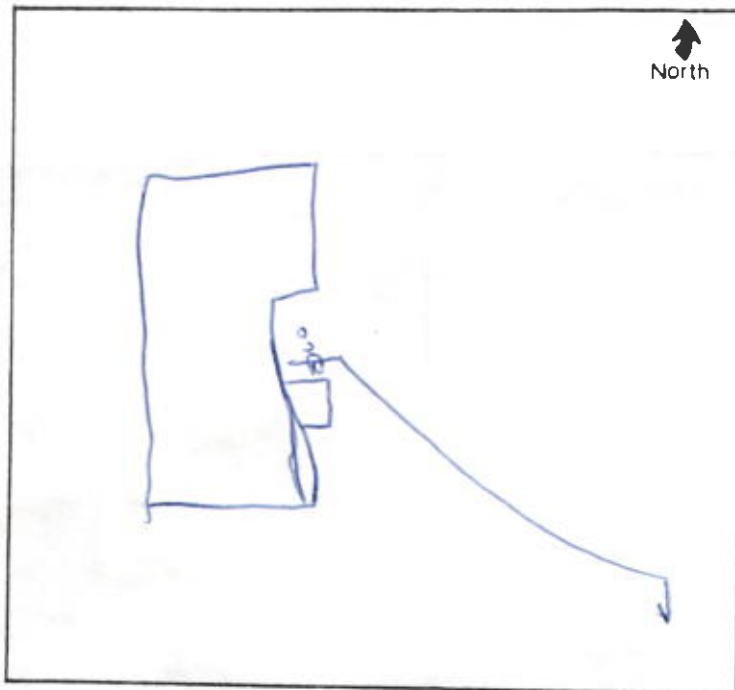

CUSTOMER OUT

ACCOUNT NUMBER : \_\_\_\_\_

CODE: 3

CUSTOMER NAME : \_\_\_\_\_

SERVICE ADDRS :

FORWARD ADDRS :

OWNER INFO :

PHONE NO. \_\_\_\_\_

OUT DATE : \_\_\_\_\_ CIRCLE ONE:      SOLD      RENTED

FINAL SENT DATE: \_\_\_\_\_ FINAL ON COMP DATE: \_\_\_\_\_

### CALCULATION OF FINAL BILL

Sewage Arrears  
Penalty balance  
Other

\_\_\_\_\_ TO \_\_\_\_\_  
 \_\_\_\_\_ TO \_\_\_\_\_  
 \_\_\_\_\_ TO \_\_\_\_\_

**BALANCE DUE ON FINAL BILL**

OTHER INFO :

CUSTOMER IN

ACCOUNT NUMBER : 22-27054.00 DAY TIME PHONE: 640-0323

CUSTOMER NAME(S) P. Eric Myers  
SS#(s) \_\_\_\_\_

SERVICE ADDR : 1812 W. Raccoon Way lot 39

Pendleton, IN 46064

MAILING ADDR : 827 Harvey Street, Anderson In 46012

IF DIFFERENT THAN ABOVE)

IN DATE : ADMIN LETTER: MONTH ADDED \_\_\_\_\_

CALCULATIONS : TO AMOUNT: \_\_\_\_\_

OTHER INFO : Permit # 2139 9/26/94

inspected 9/29/94 - Ben

# 827 Harvey Street  
Anderson, IN 46012