




1813 Madewood

Lot 53 Huntzinger Farms

2-16-17

2-16-17
Hursts. F.
DR Watson

N
↓

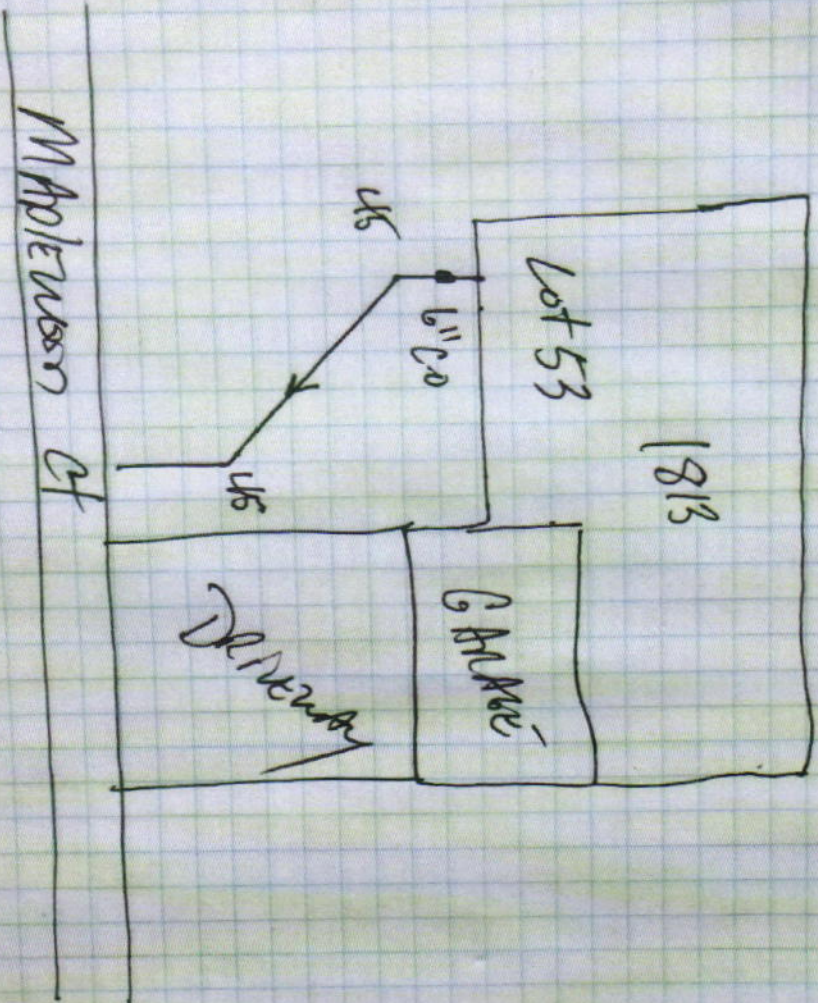

ARBOR HOMES, L.L.C.
PERMIT ACCOUNT
6626 E. 75TH STREET, SUITE 400
INDIANAPOLIS, IN 46250



71-65/749
First Merchants Bank
www.firstmerchants.com

029809

DATE 11/7/2016

PAY
TO THE
ORDER OF

Fall Creek Regional Waste District

\$ 3,370.00

Three Thousand Three Hundred And Seventy Dollars And 0/100

DOLLARS

FOR

HUNTZ 53



BY:

NOT VALID FOR AMOUNTS OVER \$10,000

AUTHORIZED SIGNATURE

Rec. #010557