

Agreement for Sanitary Sewer Service

This Agreement made and entered into this 5 day of Nov, 2015 between Fall Creek Regional Waste District ("District") and Arbor Homes, LLC ("Applicant") regarding the provision of sanitary sewer service, and the assignment of capacity in and connection to, the District's facilities for the premises located at 1816 Maplewood Ct. Pendleton, IN 46064

Now therefore, the parties, in consideration of the mutual promises set out in this Agreement, the receipt and sufficiency of which is hereby acknowledged, agree as follows:

1. The Applicant agrees that all workmanship and materials shall conform to all District ordinances and the District's construction standards. District must accept and approve all work and materials before backfilling and final connection is made to the sewer mains. Any violation of this provision will cause all lines and appurtenances in violation to be removed and replaced at the Applicant's expense.
2. The District shall have the right to enter upon the Applicant's premises at all reasonable times to inspect, repair, or replace any equipment used in connection with the District's service or which has an impact on said service.
3. The Applicant shall be responsible for all monthly user rates, capacity charges, and tap fees. The failure to pay any rate charge or fee may result in a lien against the property and/or the termination of service to the property, the cost of which will be borne by Applicant, including, but not limited to, all attorney's fees and collection costs.
4. The District shall not be responsible for any damages as a result of any failure to supply service unless said damages are due to default, neglect or culpability on the part of the District.
5. If there is an available sanitary sewer within three hundred (300) feet of the property line, the property owner shall be required to connect to the District's sanitary sewer system.
6. The Applicant and District agree that the provision of sanitary sewer service touches and concerns the property and the terms of this Agreement bind the District and Applicant and their heirs, executors, administrators, personal representatives, successors, agents, attorneys, assigns, designees, and transferees.

The parties hereto have read and fully understand the above provisions and agree to comply with said provisions.

FALL CREEK REGIONAL WASTE DISTRICT
Rachel E. Anderson
 Signature

APPLICANT
Cindy [Signature]
 Signature


STATE OF INDIANA)
) SS:
 COUNTY OF MADISON)



SUBSCRIBED and sworn to before me this 5 day of Nov, 2015
 Signature Rachel E. Anderson
 Printed Rachel E. Anderson
 Notary Public
 Resident of Madison County

Inspector Don Date Inspected 11-14 Approved Rejected
 Reason for Rejection _____
 Date Reinspected _____ Approved _____ Rejected _____

Notes:
 Size Pipe 6" Type Pipe PVC
 Basement Yes No
 Sump Pump Yes No
 Downspout to Ground Yes No
 Septic Tank Pumped & Filled Yes No
 Contractor DR. WATSON
 Special Conditions _____
 Existing Home _____
 New Construction

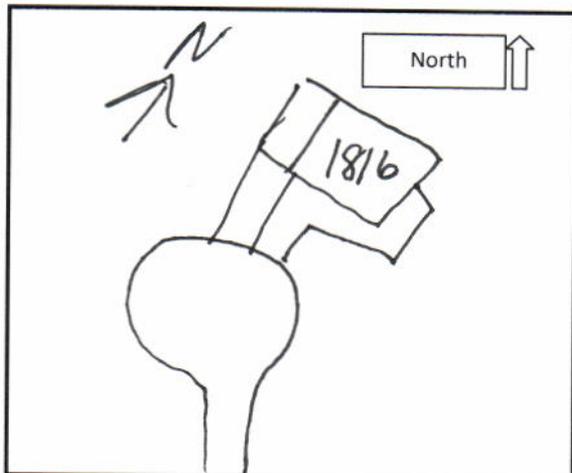

1 picture attached

1814 Maplewood

HF Lot 50



OVERHEAD DO
INSULATION DIVISION
 Customer Satisfaction Is Our

Grip Rite[®]

www.grip-rite.com

House-Wrap-LWE

ICC-ESR-3729, Grade D
 MEETS ASTM E 2178

Grip Rite[®]

www.grip-rite.com

House-Wrap-LWE

ICC-ESR-3729, Grade D
 MEETS ASTM E 2178

ARBOR HOMES, L.L.C.
PERMIT ACCOUNT
6626 E. 75TH STREET, SUITE 400
INDIANAPOLIS, IN 46250

71-65/749
First Merchants Bank
www.firstmerchants.com

027609

DATE 10/20/2015

PAY TO THE ORDER OF Fall Creek Regional Waste District

\$ 3,370.00

Three Thousand Three Hundred And Seventy Dollars And 0/100

DOLLARS

FOR HUNTZ 50



NOT VALID FOR AMOUNTS OVER \$10,000
[Handwritten Signature]
AUTHORIZED SIGNATURE

Rec # 010401
Cap fee } pd 11-575
Tap fee }
Huntzinger Farms