



FALL CREEK REGIONAL WASTE DISTRICT

Box 44, Pendleton, Indiana 46064

add order
on file

22-27120.00

APPLICATION FOR SEWER PERMIT

Nº 001961

Permit No. _____ Date 11-5-93

Permit Void 90 days from Date of Issuance

Owner Name Jim Short

Property Address 1819 RACCOON WAY

Lot # 31 P.O. Box _____

Town PENDLETON, IN Zip Code 46064

Phone _____ Water Meter _____

\$ 350.00 (12/22/93) Tap on Fee Paid availability fee 2,000 4-14-94

\$ 25.00 (12/22/93) Inspection fee paid interior line fee 1243.50

Application is hereby made for connection to the Fall Creek Regional Waste District Sewer System for the above listed property - Permit Type: Residential ☒, Commercial _____, Industrial _____, or Governmental/Institutional _____. User Information _____.

All workmanship and materials shall conform to the standards of the District Ordinance as described in Ordinance 84-2 and 84-3 as amended. Acceptance and approval must be made by the District inspector or his duly authorized representative before backfilling and final connection is made to the main sewer lines. Any violation of applicable regulations will cause all lines and appurtenances in violation to be removed and replaced at the owners expense.

The Fall Creek Regional Waste District is responsible for the inspection, approval of materials, and installation techniques only. All costs for materials and installation and any liabilities resulting from same is the sole responsibility of the property owner.

I have read and fully understand the above provisions and agree to comply by said provisions.


James R Short 12-15-93
APPLICANT(S) SIGNATURE

INSPECTOR TIM/B
Date inspected 11/5 12/28 Approved _____ Rejected _____

Reason for rejection _____

Date reinspected _____ Approved _____ Rejected _____

Notes:
Size Pipe 6" ✓
Type Pipe SDR 35
Basement Yes _____ No ☒
Sump Pump Yes _____ No ☒
Downspout to Ground Yes ☒ No _____
Septic Tank Pumped & filled Yes ☒ No _____
Contractor Doug Bolton
Special Conditions NEW HOME
TEMP. TANK

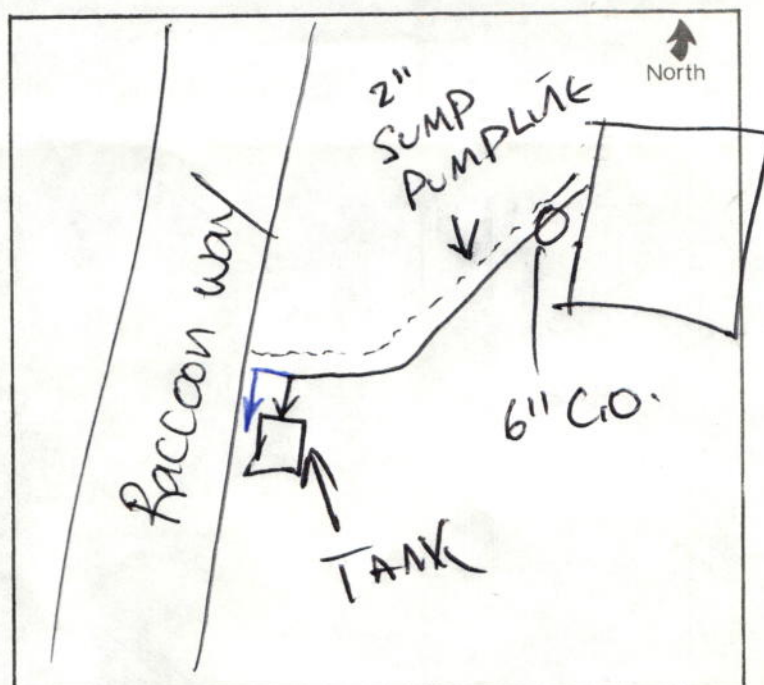



FALL CREEK REGIONAL WASTE DISTRICT

Box 44, Pendleton, Indiana 46064

NO 001361

11-2-83

11-2-83

